

CERTIFIED RECORD OF LAND CORNER MONUMENTATION

(Reference FSH 5681.65)

History of original corner establishment:

No previous establishment of this corner, as it is a part of the Subdivision of Sec. 7, T 10 S, R 36 E, WM, Baker County, Oregon.

DIAGRAM
T 10 S
N 1/64
7 | 8
R 36 E
1967
#646

Description of corner evidence found:


No corner evidence to be found.

Description of monument and accessories I established to perpetuate the original location of this corner

Set a 1 inch x 30 inch iron pipe with aluminum cap and stamped as shown on the above diagram.

I placed a mound of stone about the base of pipe, with the dimensions of 3 feet in dia. and 1 $\frac{1}{2}$ feet high.

Blazed the property line and placed forest boundary markers at approx. 300 foot intervals along the line, with markers in both directions at the corners.

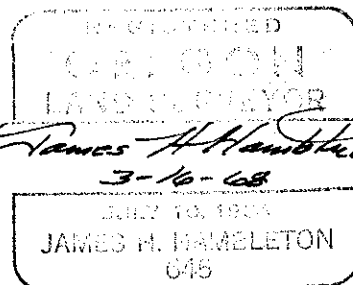

Office of County Surveyor County of Baker
State of Oregon, I hereby certify that the within instrument was filed in this office
for record on the 28 day of March, 1968, at 5 o'clock P.m., (signed)
_____ by Tom Hamley
(COUNTY OFFICIAL) (DEPUTY)