


P-9160-2
Nov. 1964

UNITED STATES
DEPARTMENT OF THE INTERIOR
BUREAU OF LAND MANAGEMENT
TOWNSHIP DIAGRAM
SCALE: 1 INCH = 1 MILE

TOWNSHIP 10 South, RANGE 36 East, Willamette MER.
STATE Oregon

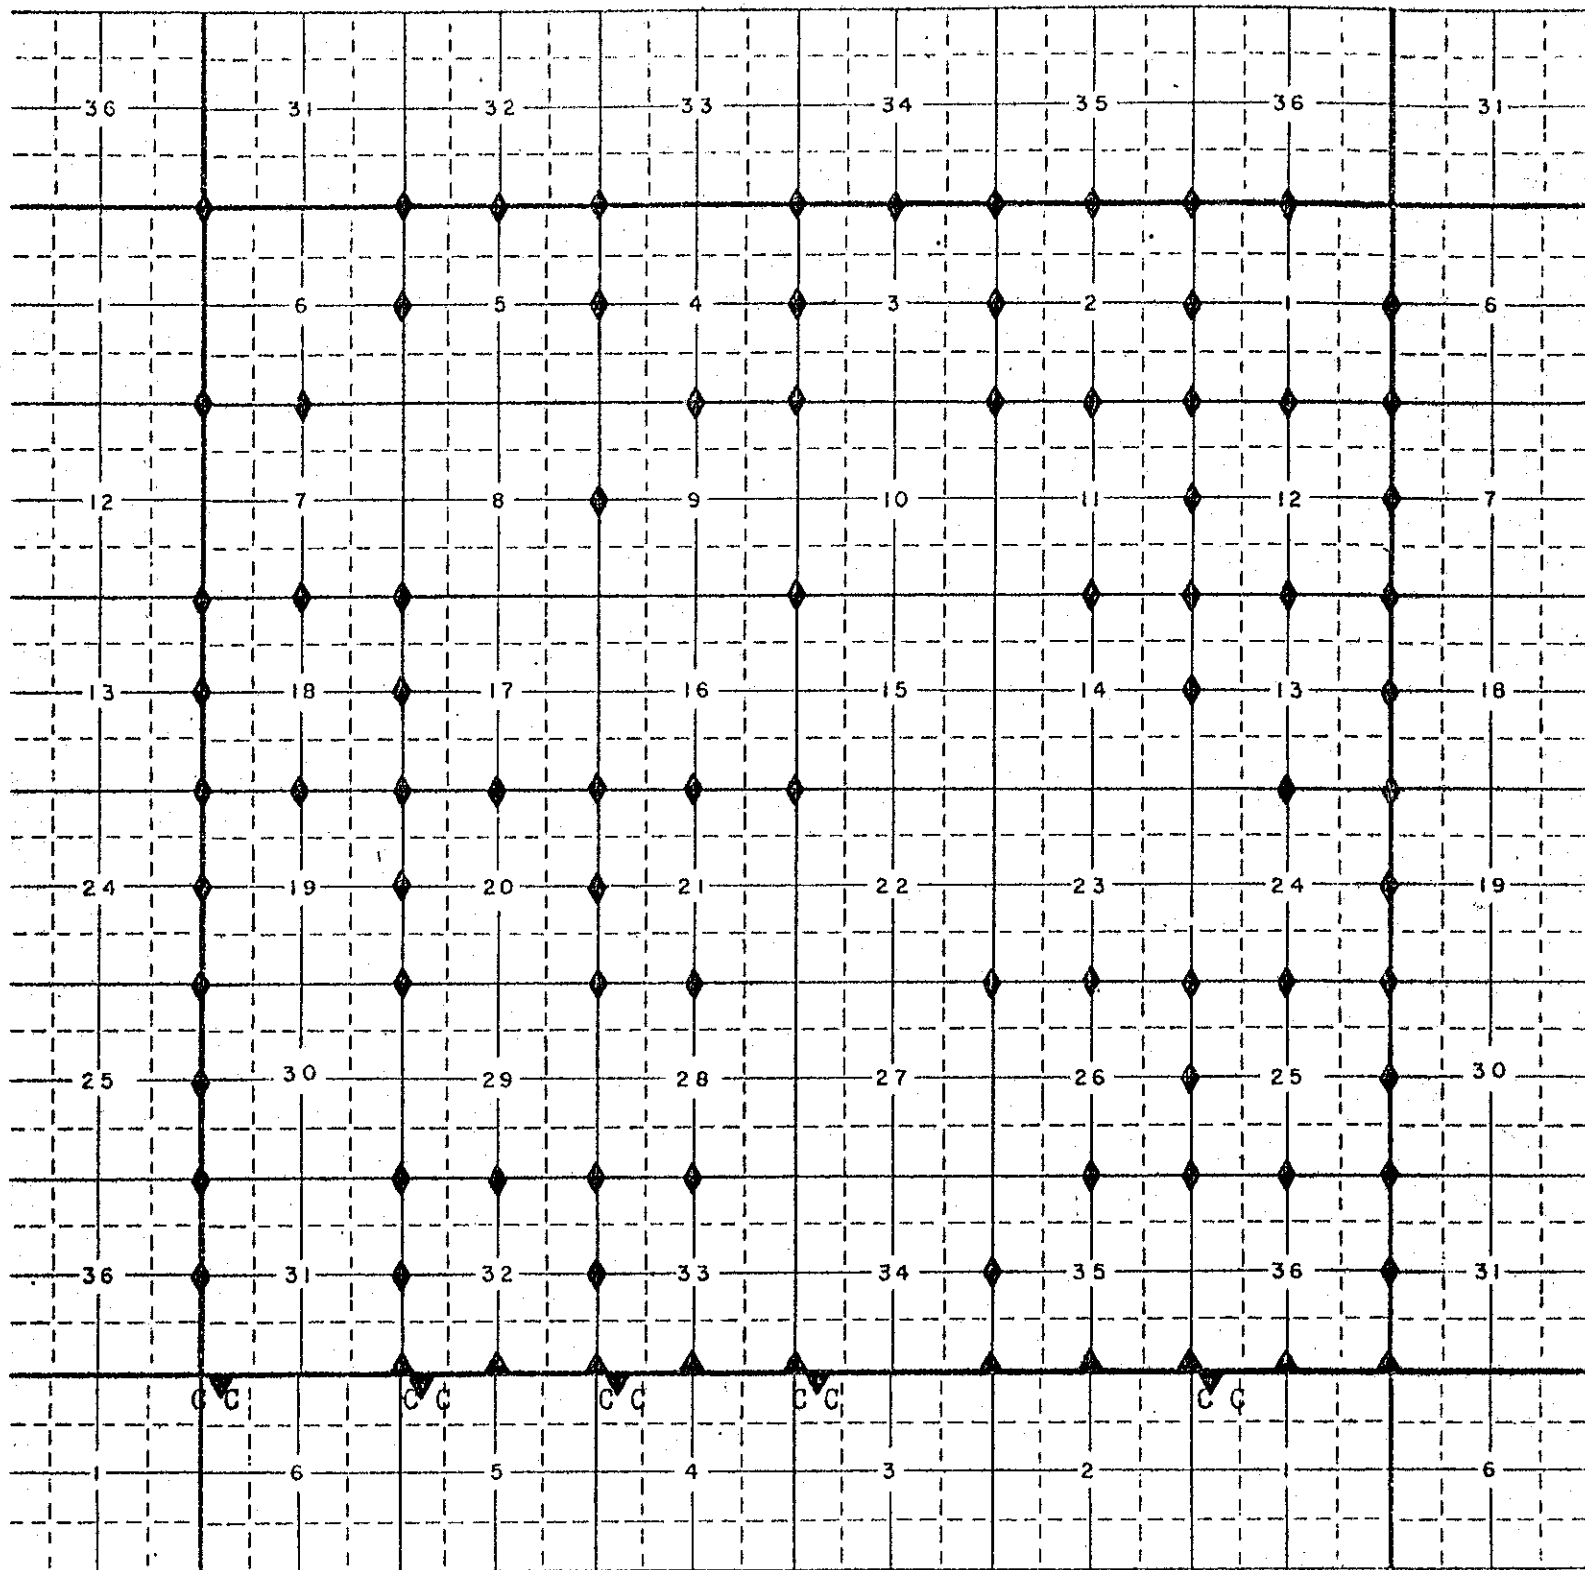

Baker County

Wallowa-Whitman National Forest, Region 6

◆ Corners Remonumented

Nov. 18, 1974

LAND OFFICE, BLM

SURVEY NO. 10-36-24