

SURVEY FOR
U.S. FOREST SERVICE
GIMLET OLIVE CADASTRAL


CONTRACT NO. 53-04M3-2-2789
RETRACEMENT OF MINERAL SURVEY NO. 225
MEDOCK CLAIM, EVENING STAR CLAIM

SATURN CLAIM
TIOS R36E, W.M.

SCALE 1" = 300'


300 0 300
60.97 M 60.97 M
1 METER = 3.28083 FT.

DECEMBER 29, 1982
BAKER COUNTY, OREGON

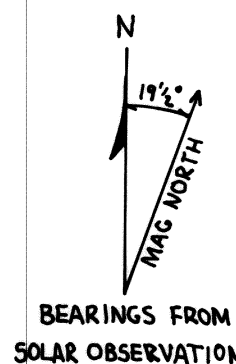

LEGEND

- CORNER EVIDENCE FOUND
- CORNER SET BY SURVEY
- /// PROPERTY LINE POSTED WITH 6 FT. STEEL POSTS AND USFS SIGNS 54-2
- () BEARINGS AND DISTANCES OF RECORD BY ORIGINAL GLO SURVEY
- [] BEARINGS AND DISTANCES OF RECORD BY JAMES D. HANLEY SURVEY 1964 CS#10-36-1

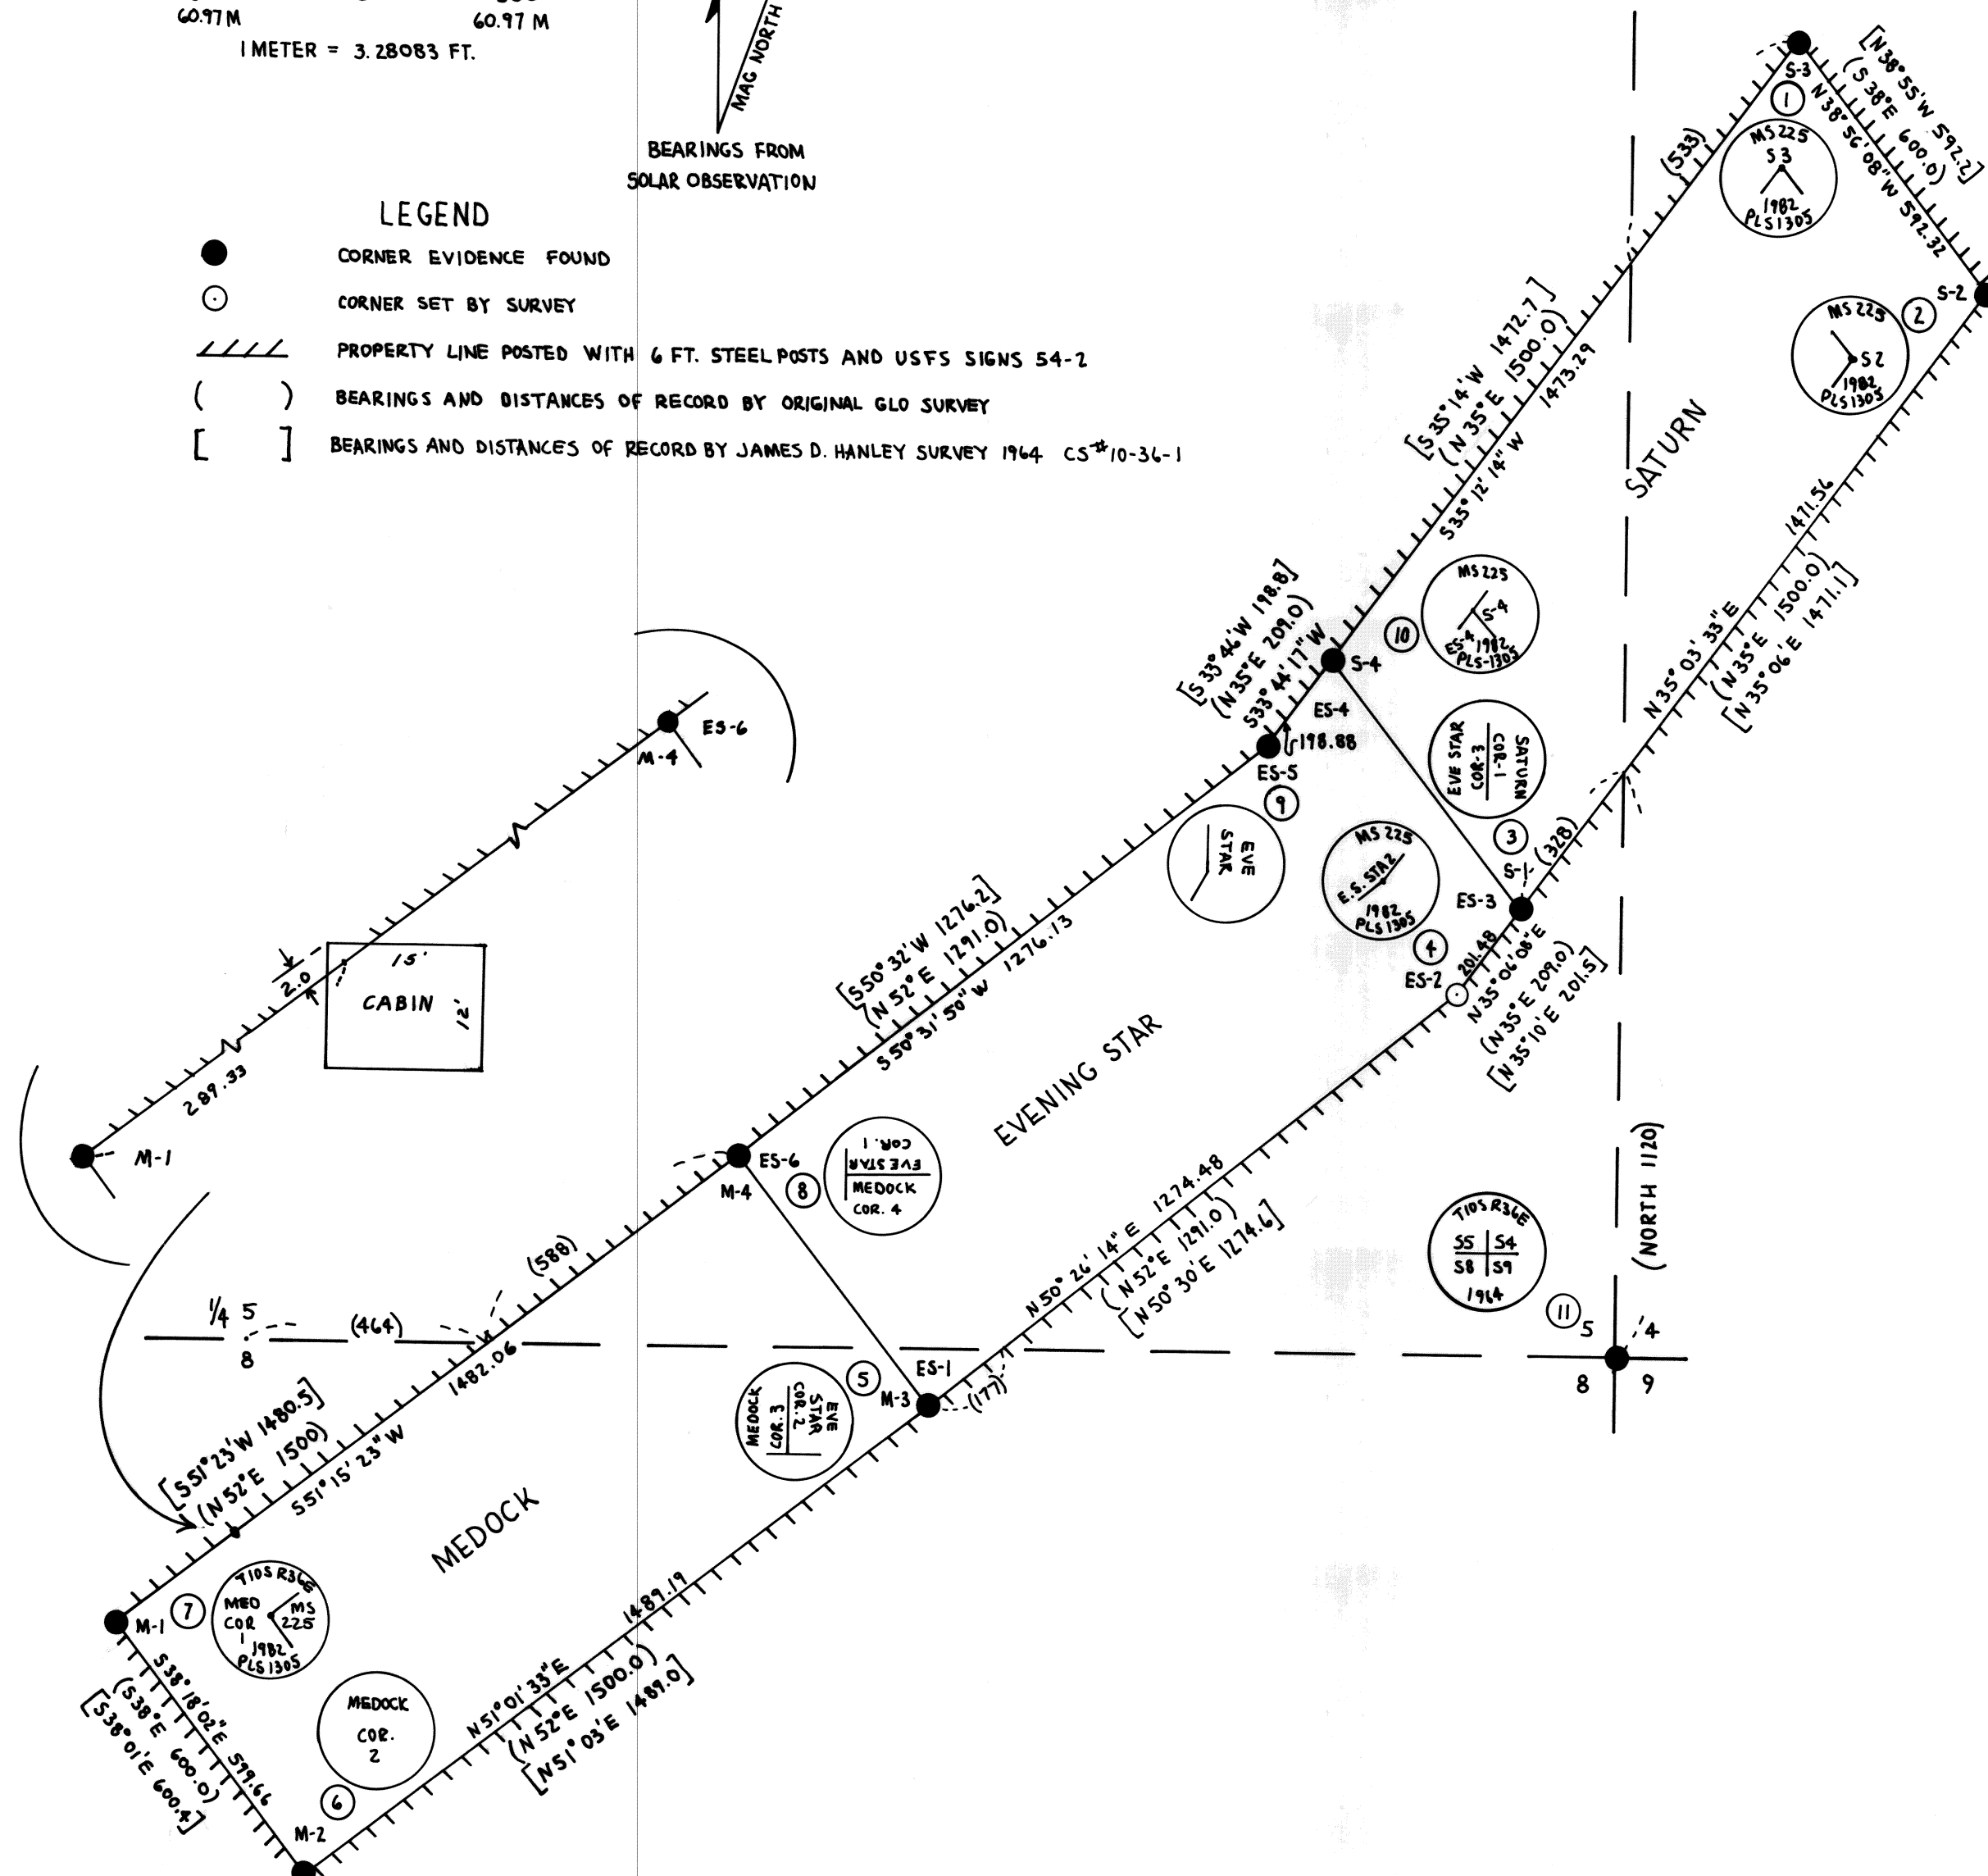


NOTE: ALL NEW BTS ARE MARKED PER BLM MANUAL AND IN ADDITION HAVE A BRASS WASHER MARKED LS 1305 NAILED FLUSH IN LOWER BLAZE. ALL BTS ARE PAINTED WITH A 6" RED BAND AND ARE TAGGED WITH APPROPRIATE SIGNS. ALL CORNERS ARE STAMPED PER BLM MANUAL PLUS PLS 1305 AND 1982. 6 FT. STEEL POSTS WERE SET 3 TO 5 FT. FROM ALL CORNERS AS PER CONTRACT. FIELD NOTES ARE IN BOOK Z-CONTRACT NO. 53-04M3-2-2789.

CORNER NO.	MONUMENT	ACCESSORIES
①	FD. 2" ALUM. CAP IN 1" GI PIPE SET BY HANLEY, KNOCKED OUT BY LOGGING. SET 2 1/2" BRASS CAP IN 2 1/2" G.I.P. - ROCK MOUND. BURIED HANLEY'S MONUMENT	FD. ORIGINAL BTS: 26" DOWN P. PINE BEARS S 39° W 34.3 FT.; 24" DOWN P. PINE BEARS S 53° W 31.6 FT. SCRIBED BTS: 9" D. FIR BEARS N 10° W 73.7 FT., SCRIBED MS 225 S 3 BT; 11" P. PINE BEARS N 85° E 87.6 FT., SCRIBED MS 225 S 3 BT.
②	FD. 2" AL. CAP IN 1" GI PIPE SET BY HANLEY, KNOCKED OUT BY LOGGING. SET 2 1/2" BRASS CAP IN 2 1/2" G.I.P. - ROCK MOUND. BURIED HANLEY'S MONUMENT.	FD. ORIGINAL BTS: 20" P. PINE STUMP BEARS N 88° W 33 FT.; 24" P. PINE STUMP BEARS N 4° W 19.8 FT. SCRIBED BTS: 11" D. FIR BEARS N 33° W 74.3 FT., SCRIBED MS 225 S 2 BT; 15" P. PINE BEARS S 86° W 72.8 FT., SCRIBED MS 225 S 2 BT.
③	FD. 2 1/2" ALUM. CAP IN 1" GI PIPE SET BY HANLEY ORE 2808.	FD. ORIGINAL BTS: 20" P. PINE BEARS N 7° E 19.1 FT.; 20" DOWN P. PINE BEARS S 59° W 25.1 FT. SCRIBED BTS: 7" P. PINE BEARS N 19° W 43.8 FT., SCRIBED MS 225 ES-3 S-1 BT; 8" D. FIR BEARS N 88° W 29.9 FT., SCRIBED MS 225 ES-3 S-1 BT.
④	SET 2 1/2" BRASS CAP IN 2 1/2" X 30" GI PIPE - ROCK MOUND.	SCRIBED BTS: 11" P. PINE BEARS S 9° E 44.4 FT., SCRIBED MS 225 ES-STA 2; 8" D. FIR BEARS N 82° E 53.0 FT., SCRIBED MS 225 ES-STA 2.
⑤	FD. 2 1/2" ALUM. CAP IN 1" GI PIPE SET BY HANLEY - ROCK MOUND.	FD. ORIGINAL BTS: 14" PINE STUMP BEARS N 14° E 17.8 FT.; 20" PINE STUMP BEARS S 78° W 32.3 FT. SCRIBED BTS: 17" P. PINE BEARS N 8° E 8.7 FT., SCRIBED MS 225 M 3 ES 2 BT; 13" P. PINE BEARS N 67° W 22.0 FT., SCRIBED MS 225 M 3 ES 2 BT.
⑥	FD. 2 1/2" ALUM. CAP IN 1" GI PIPE SET BY HANLEY.	FD. ORIGINAL BTS: 16" LARCH STUMP BEARS N 16° E 5.3 FT.; ROTTEN STUMP HOLE BEARS N 66° E 19.8 FT. SCRIBED BTS: 8" LARCH BEARS N 84° W 16.1 FT., SCRIBED MS 225 M 2 BT; 12" LARCH BEARS S 64° E 11.1 FT., SCRIBED MS 225 M 2 BT.
⑦	FD. 2 1/2" ALUM. CAP IN 1" GI PIPE SET BY HANLEY BEARS S 63° W 4.0 FT. FD. ORIGINAL EARTH MOUND. SET 2 1/2" BRASS CAP IN 2 1/2" X 30" GI PIPE IN ORIGINAL EARTH MOUND.	FD. ORIGINAL BTS: 10" DOWN LARCH BEARS S 15° E 19.8 FT.; 20" LARCH SNAG BEARS N 82° W 24.4 FT. SCRIBED BTS: 7" D. FIR BEARS N 33° E 26.7 FT., SCRIBED MS 225 M 1 BT; 11" LARCH BEARS S 35° E 17.9 FT., SCRIBED MS 225 M 1 BT.
⑧	FD. 2 1/2" ALUM. CAP IN 1" GI PIPE SET BY HANLEY.	FD. ORIGINAL BTS: 16" DOWN D. FIR BEARS S 6° E 15.2 FT.; 25" PINE BEARS N 6° E 15.2 FT. SCRIBED BTS: 7" D. FIR BEARS S 63° E 41.4 FT., SCRIBED MS 225 M 4 ES 1 BT; 16" P. PINE BEARS S 31° W 58.4 FT., SCRIBED MS 225 M 4 ES 1 BT.
⑨	FD. 2 1/2" ALUM. CAP IN 1" GI PIPE SET BY HANLEY.	FD. ORIGINAL BTS: 30" FIR STUMP BEARS S 77° E 23.1 FT.; 30" DOWN FIR BEARS N 40° W 35.0 FT. SCRIBED BTS: 11" D. FIR BEARS S 78° E 8.5 FT., SCRIBED MS 225 ES 5 BT; 9" W. FIR BEARS N 23° E 16.7 FT., SCRIBED MS 225 ES 5 BT.
⑩	SET 2 1/2" BRASS CAP IN 2 1/2" X 30" GI PIPE - ROCK MOUND.	FD. ORIGINAL BT: FIR STUMP BEARS N 81 1/2° W 23.8 FT. SCRIBED BTS: 10" P. PINE BEARS N 46° E 48.9 FT., SCRIBED MS 225 S 4 ES 4 BT; 8" E. SPRUCE BEARS WEST 43.7 FT., SCRIBED MS 225 S 4 ES 4 BT.
⑪	FD. 2" ALUM. CAP IN 1" GI PIPE SET BY HANLEY.	FD. ORIGINAL BTS: 20" D. FIR BEARS N 55° W 81.2 FT.; 27" P. PINE BEARS S 55° W 89.8 FT.; 33" P. PINE SNAG BEARS N 15° E 37.6 FT. SCRIBED BTS: 7" D. FIR BEARS N 28° W 31.4 FT., SCRIBED TIOS R36E S 5 BT; 7" D. FIR BEARS N 43° E 34.0 FT., SCRIBED TIOS R36E S 4 BT; 6" D. FIR BEARS S 81° E 16.7 FT., SCRIBED TIOS R36E S 9 BT.

NARRATIVE: THIS SURVEY IS A CLOSED TRAVERSE BY T-16 THEODOLITE AND DI-4 EDM AND T-1 THEODOLITE AND 300 FT. TAPE, MADE BY JACKSON & PROCHNAU, INC. P.O. BOX 177 ALBANY, OREGON 97321. BASIS OF BEARINGS IS A SOLAR OBSERVATION. THE ORIGINAL MINING SURVEY NO. 225 WAS DONE BY CHARLES M. FOSTER IN 1890 THROUGH THE SURVEYOR GENERAL'S OFFICE. A RETRACEMENT OF MINING SURVEY NO. 225 WAS MADE IN 1964 BY JAMES D. HANLEY. EVENING STAR STA NO. 2 (COR. NO. 4) WAS SET BY PROPORTIONAL MEASURE FOLLOWING A THOROUGH SEARCH OF THE AREA.

"I, JAMES W. PROCHNAU, A REGISTERED LAND SURVEYOR IN THE STATE OF OREGON, HEREBY CERTIFY THAT THIS PLAT AND THE NOTES HEREON, OR ATTACHED, ARE A CORRECT REPRESENTATION OF A SURVEY I PERFORMED DURING JUNE THROUGH NOVEMBER, 1982 FOR THE U.S. FOREST SERVICE, IN ACCORDANCE WITH THE STATUTES OF THE STATE OF OREGON AND WITH THE ARTICLES OF MY CONTRACT."

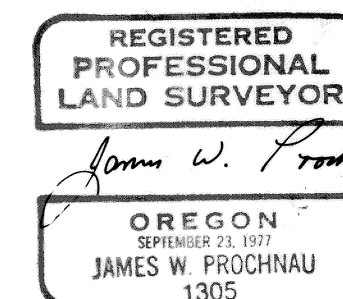

JAMES W. PROCHNAU
P.L.S. 1305, OREGON

FILED Feb. 18, 1983
BAKER COUNTY SURVEYOR
SURVEY NO. 10-36-29