


CERTIFIED RECORD OF LAND CORNER MONUMENTATION

M-9

History of original corner establishment:

None.

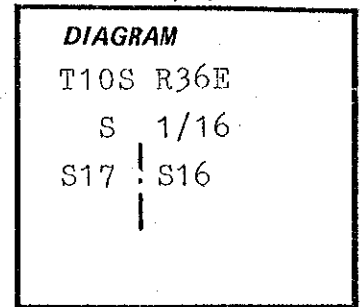

No evidence of corner establishment found in County Records.

Description of corner evidence found:

None.

Description of monument and accessories I established to perpetuate the original location of this corner:

Set a 2½" by 30" aluminum pipe with 2½" aluminum cap, 23" in the ground and surrounded with a mound of earth and stone, from which:

A 11" Ponderosa Pine bears N 49½° W-9.5', scribed: S 1/16 S 17 BT.

A 18" Ponderosa Pine bears N 28½° E - 37.0', scribed: S 1/16 S 16 BT.


New bearing trees have a brass washer stamped PLS 1106 nailed to face of blaze. Attached sign 54-3 and 54-9, and painted face of blaze and a 6" red band around each bearing tree.

Set steel fence posts on National Forest Boundary West and North of corner and attached sign 54-9 to one post, and 54-2 to both posts.


Used steel tape and staff compass with 20°E declination, measured to the center of the bearing trees.

This corner was monumented on May 9, 1986.

Witnessed by: Willard Hulick.

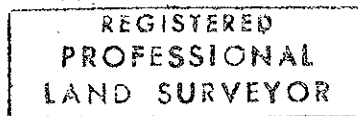


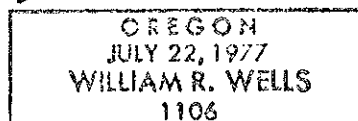

Cap is marked:

T10S R36E

S 1/16

S17 | S16

1986

PLS 1106

Office of..... County Surveyor..... County of..... Baker
State of...Oregon....., I hereby certify that the within instrument was filed in this office
for record on the..... day of....., 19.....

..... by
(COUNTY OFFICIAL) (DEPUTY)