


CERTIFIED RECORD OF LAND CORNER MONUMENTATION

History of original corner establishment:

None.

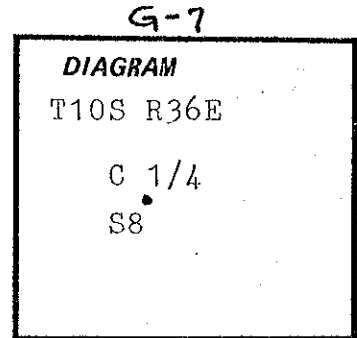

No evidence of corner establishment found in County Records.

Description of corner evidence found:

None.

Description of monument and accessories I established to perpetuate the original location of this corner:

Set a 2 1/2" by 30" aluminum pipe with 2 1/2" aluminum cap, 24" in the ground and surrounded with a mound of earth and stone, from which:

A 10" Ponderosa Pine bears S 78 1/2° E - 22.8', scribed: C 1/4 S 8 BT.

A 17" Ponderosa Pine bears N 27° W - 63.5', scribed: C 1/4 S 8 BT.


New bearing trees have a brass washer stamped PLS 1106 nailed to face of blaze. Attached sign 54-3 and 54-9 and painted face of blaze and a 6" red band around each bearing tree.

Set a steel fence post North of corner and attached sign 54-9.

Used steel tape and staff compass with 20° E declination, measured to the center of the bearing trees.

This corner was monumented on May 12, 1986.

Witnessed by: Willard Hulick.

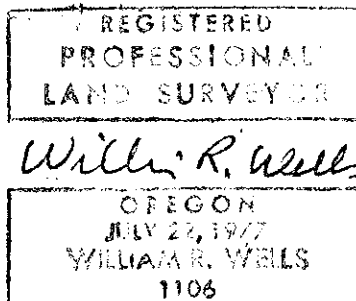

Cap is marked:

T10S R36E

C 1/4

S 8

1986

PLS 1106

Office of...County Surveyor..... County of.....Baker.....

State of.....Oregon....., I hereby certify that the within instrument was filed in this office

for record on the..... day of....., 19.....

..... by
(COUNTY OFFICIAL) (DEPUTY)