

CERTIFIED RECORD OF LAND CORNER MONUMENTATION

J-7

History of original corner establishment:

The corner was originally established by Herman D. Gradon, U. S. Deputy Surveyor, under Contract No. 416, dated August 19, 1881. The original notes state that at the corner position a 3' long by 3" square post was set 24" in the ground, marked $\frac{1}{4}$ S. on North face, from which:

A 36" Pine bears N 80° W - 105 links, marked: $\frac{1}{4}$ S BT.

A 28" Pine bears S 20° W - 48 links, marked: $\frac{1}{4}$ S BT.

No other record of corner remonumentation found in County Record.

Description of corner evidence found:

None. The corner was re-established by single proportion measure between the re-established Northeast corner of Section 17 and the found Northwest corner of Section 17. The corner area was searched for 4 hours with a 2 person crew and 1 PLS. The corner area has been logged, thinned, and burnt. The remains of two sets of stumps could be found to match original bearing tree bearings and distances. We were about 40 years too late in searching this corner.

Description of monument and accessories I established to perpetuate the original location of this corner:

Set a 2 $\frac{1}{2}$ " by 30" aluminum pipe with 2 $\frac{1}{2}$ " aluminum cap, 24" in the ground and surrounded with a mound of earth and a few stones, from which:

A 11" Ponderosa Pine bears N 43 $\frac{1}{4}$ ° E - 22.7', scribed: $\frac{1}{4}$ S8 BT.

A 11" Ponderosa Pine bears S 17° E - 19.2', scribed: $\frac{1}{4}$ S17 BT.



New bearing trees have a brass washer stamped PLS 1106 nailed to face of blaze. Attached sign 54-3 and 54-9, and painted face of blaze and a 6" red band around each bearing tree.

Set steel fence posts on National Forest Boundary North and East of corner and attached sign 54-9 to one post, and sign 54-2 to both posts.

Used steel tape and staff compass with 20°E declination, measured to the center of the bearing trees.

This corner was remonumented on May 13, 1986.

Witnessed by: Willard Hulick.

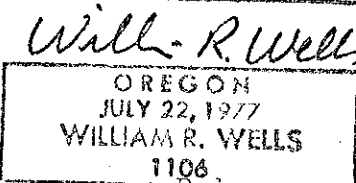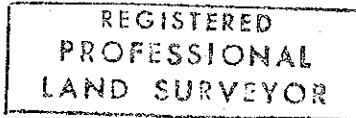

T10S R36E

$\frac{1}{4}$ $\frac{S8}{S17}$

1986

PLS 1106

Office of..... County Surveyor..... County of.....
 State of..... Oregon....., I hereby certify that the within instrument was filed in this office
 for record on the..... day of....., 19.....

..... by
 (COUNTY OFFICIAL) (DEPUTY)