


CERTIFIED RECORD OF LAND CORNER MONUMENTATION

J-9

History of original corner establishment:

The corner was originally established by Herman D. Graddon, U. S. Deputy Surveyor, under Contract No. 416, dated August 19, 1881. The original notes state that at the corner position a 4' long by 4" square post was set 24" in the ground, marked: T10S - S9 on Northeast; R36E - S16 on Southeast; S17 on Southwest; and S8 on Northwest faces, with 4 notches on South and East edges, from which:

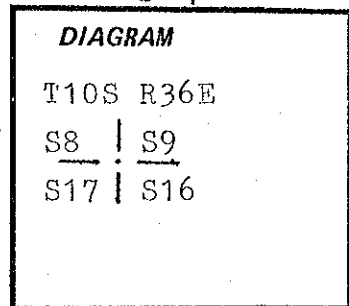

- A 36" Pine bears N 40° E - 66 links, marked: T10S R36E S9 BT.
 - A 36" Pine bears S 70° E - 35 links, marked: T10S R36E S16 BT.
 - A 30" Pine bears S 65° W - 34 links, marked: T10S R36E S17 BT.
 - A 40" Pine bears N 45° W - 44 links, marked T10S R36E S8 BT.
- No other record of corner remonumentation found in County Record.

Description of corner evidence found:

None. Spent 4½ hours searching for corner with 2 man crew and 1 PLS. The area has been logged years ago, burnt, and thinned more recently. Original surveyor used high blazes and scribes, making identification of original bearing tree stumps almost impossible, even if the stumps had'nt rotted away. Re-established corner by double proportion measure from W ¼ S 8 to North, Southeast corner S 9 to East, Southeast corner S 17 to South, and Northwest corner S 17 to West.

REGISTERED PROFESSIONAL LAND SURVEYOR

Will R. Wells

OREGON JULY 22, 1977 WILLIAM R. WELLS 1106

Description of monument and accessories | established to perpetuate the original location of this corner:

Set a 2½" by 30" aluminum pipe with 2½" aluminum cap, 24" in the ground and surrounded with a mound of earth and stone, from which:

- A 11" Western Larch bears N 63½° E - 40.8', scribed: T10S R36E S9 BT.
- A 13" Ponderosa Pine bears S 33½° E - 19.2', scribed: T10S R36E S16 BT.
- A 13" Ponderosa Pine bears S 41½° W - 33.9', scribed: T10S R36E S17 BT.
- A 10" Ponderosa Pine bears N 27° W - 16.0', scribed: T10S R36E S8 BT.

New bearing trees have a brass washer stamped PLS 1106 nailed to face of blaze. Attached sign 54-3 and 54-9 to each bearing tree, and painted face of blaze and a 6" red band around each bearing tree.

Set steel fence posts on National Forest Boundary South and East of corner and attached sign 54-9 to one post, and 54-2 to both posts.

Used steel tape and staff compass with 20° E declination, measured to the center of the bearing trees.

This corner was remonumented on May 9, 1986.

Witnessed by: Willard Hulick

Cap is marked:

T10S R36E	
S8	S9
S17	S16
1986	
PLS 1106	

Office of.....County Surveyor..... County of.....Baker.....
 State of.....Oregon....., I hereby certify that the within instrument was filed in this office
 for record on the..... day of....., 19.....

..... by
 (COUNTY OFFICIAL) (DEPUTY)

FILED June 9, 1986
 BAKER COUNTY SURVEYOR
 SURVEY NO. 10-36-52