

CERTIFIED RECORD OF LAND CORNER MONUMENTATION

J-11

History of original corner establishment:

The corner was originally established by Herman D. Gradow U. S. Deputy Surveyor, under Contract No. 416, dated August 19, 1881. The original notes state that at the corner position a basalt stone 14" x 12" x 6" was set 9" in the ground, marked $\frac{1}{4}$ on North face, from which:

A 8" Cottonwood bears N 70° E - 26 links, marked $\frac{1}{4}$ S BT.

A 4" Cottonwood bears S 75° E - 75 links, marked $\frac{1}{4}$ S BT.

DIAGRAM

T10S R36E

$\frac{1}{4}$ $\frac{S9}{S16}$

No other record of corner remonumentation found in County Record.

Description of corner evidence found:

None. The corner area was searched for based on creek call and position by survey for 4 hours with a 2 person crew and 1 PLS. The creek may have been moved due to placer mining so topo call could not be used to re-establish position. Cottonwood bearing trees are gone and most stones in area have been moved by mining. Found 2 Ponderosa Pines with west facing blank blazes (old) West of corner vicinity. Re-established corner by single proportion measure between re-established Southwest corner S9 and found Southeast corner S9. Fence corner bears S 40° E - 35'; fences are East - West and North.

Description of monument and accessories I established to perpetuate the original location of this corner:

Set a 2 $\frac{1}{2}$ " by 30" aluminum pipe with 2 $\frac{1}{2}$ " aluminum cap, 24" in the ground and surrounded with a mound of earth and stone, from which:

A 12" Ponderosa Pine bears N 45° E - 25.9', scribed: $\frac{1}{4}$ S9 BT.

A 7" Ponderosa Pine bears S 75 $\frac{1}{2}$ ° E - 50.6', scribed: $\frac{1}{4}$ S16 BT.

New bearing trees have a brass washer stamped PLS 1106 nailed to face of blaze. Attached sign 54-3 and 54-9, and painted face of blaze and a 6" red band around each bearing tree.


Set steel fence posts on National Forest Boundary North and West of corner and attached sign 54-9 to one post, and 54-2 to both posts.

Used steel tape and staff compass with 20°E declination, measured to the center of the bearing trees.


This corner was remonumented on May 9, 1986.

Cap is marked:

Witnessed by: Willard Hulick

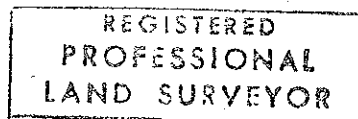

Will R. Wells

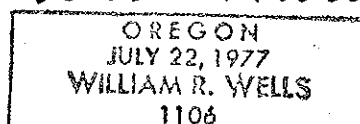

T10S R36E

$\frac{1}{4}$ $\frac{S9}{S16}$

1986
PLS 1106

Office of.....County Surveyor.....County of.....Baker.....

State of.....Oregon....., I hereby certify that the within instrument was filed in this office for record on the.....day of....., 19.....

.....by.....
(COUNTY OFFICIAL) (DEPUTY)