

CERTIFIED RECORD OF LAND CORNER MONUMENTATION


G-13

History of original corner establishment:

The corner was originally established by Herman D. Gradon, U. S. Deputy Surveyor, under Contract No. 416, dated August 19, 1881. The original notes state that at the corner position a 3' long by 3" square post, set 24" in the ground, marked $\frac{1}{4}$ S on West face, from which:

A 24" Fir bears N 50° E - 21 links, marked: $\frac{1}{4}$ S BT.

A 24" Pine bears N 50° W - 55 links, marked: $\frac{1}{4}$ S BT.

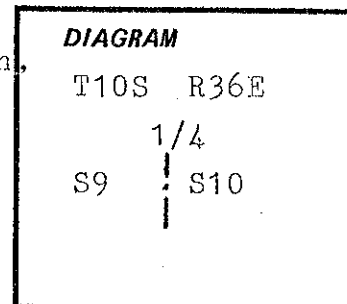

No other record of corner remonumentation found in County Record.

Description of corner evidence found:

None. Corner was thoroughly searched for 4 hours with a 2 man crew with 1 PLS. The area has been logged years ago, thinned more recently, and burnt. The remaining stumps are weathered and rotted. Corner search came about 40 years too late! Re-established corner by single proportion measure between the found Northeast corner and Southeast corner of Section 9.

Description of monument and accessories I established to perpetuate the original location of this corner:

Set a 2 $\frac{1}{2}$ " by 30" aluminum pipe with 2 $\frac{1}{2}$ " aluminum cap, 25" in the ground and surrounded with a mound of earth and stone, from which:

A 10" Ponderosa Pine bears N 10° E - 12.6', scribed: $\frac{1}{4}$ S 10 BT.

A 20" Ponderosa Pine bears S 81 $\frac{1}{2}$ ° W - 51.2', scribed: $\frac{1}{4}$ S 9 BT.


New bearing trees have a brass washer stamped PLS 1106 nailed to face of blaze. Attached sign 54-3 and 54-9, and painted face of blaze and a 6" red band around each bearing tree.

Set steel fence post north of corner and attached sign 54-9.


Used steel tape and staff compass with 20°E declination, measured to the center of the bearing trees.

This corner was remonumented on May 9, 1986.

Witnessed by: Willard Hulick

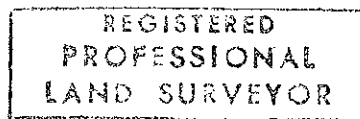

William R. Wells

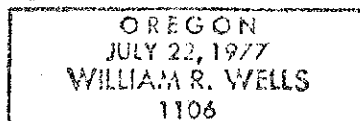

Cap is marked:

T10S R36E
 $\frac{1}{4}$
S9 | S10
1986
PLS 1106

Office of..... County Surveyor..... County of..... Baker
State of..... Oregon....., I hereby certify that the within instrument was filed in this office
for record on the..... day of....., 19.....

..... by
(COUNTY OFFICIAL) (DEPUTY)