


CERTIFIED RECORD OF LAND CORNER MONUMENTATION

P-17

History of original corner establishment:

This corner was originally established by Herman D. Graddon, U. S. Deputy Surveyor, under Contract No. 416, dated August 19, 1881, during November 1881. The original notes state that at the corner a 3½' long by 3" square marked post was set 24" in the ground, from which:

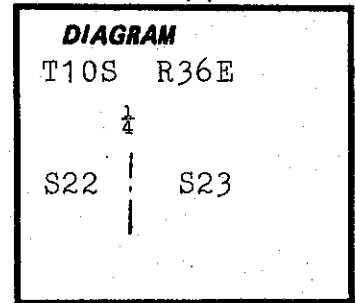


A 16" Pine bears S 40° E - 54 lks., marked: ¼ S BT.

A 16" Pine bears S 75° W - 20 lks., marked: ¼ S BT.

Description of corner evidence found:

A 20" Ponderosa Pine bears S 75° W - 13.2', with healed blaze.

Re-established corner position by measuring N 75° E - 13.2' from found bearing tree.

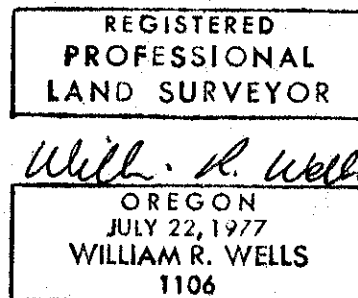

Description of monument and accessories I established to perpetuate the original location of this corner:

Set a 2½" by 30" aluminum pipe with 2½" aluminum cap 23" in the ground and surrounded with a mound of earth, from which:

A 9" Ponderosa Pine bears S 61½° E - 66.4', scribed: ¼ S23 BT.

New bearing trees have a brass washer stamped PLS 1106 nailed to face of blaze. Attached signs 54-3 and 54-9, and painted face of blaze and a 6" red band around each bearing tree.

Set steel fence post North of corner, and attached sign 54-9.

Used steel tape and staff compass with 19°E declination, measured to the center of the bearing trees.

This corner was remonumented on July 9, 1986.

Witnessed by: Willard Hulick.

Cap is marked:
T10S R36E
¼
S22 | S23
1986
PLS 1106

Office of.....County Surveyor..... County of.....Baker
State of.....Oregon.....hereby certify that the within instrument was filed in this office
for record on the..... day of....., 19.....
..... by
(COUNTY OFFICIAL) (DEPUTY)