

CERTIFIED RECORD OF LAND CORNER MONUMENTATION

INDEX No. R-15

History of original corner establishment:

Corner was originally established in 1881,
by Herman D. Gradon, under General Land Office
Contract No. 416. U.S. Surveyor General's Notes
State: Set a post 3 ft. long 3 ins square 24 ins.
in the ground for 1/4 sec. cor. marked 1/4 S on N
face.

from which:

A pine 36 ins diam bears N45°W., 45 lks. dist. marked 1/4 S BT
A pine 36 ins diam bears S40°W., 104 lks. dist. marked 1/4 S BT

DIAGRAM

T10S R36E
S22
1/4--
S27
1988
PLS 848

Description of corner evidence found:

No trace of the original post is remaining.

Examined all the tree remains in the area with
no marks or evidence being identified. There are no
trees or remains of trees with conform to record
measure. The search area here is well defined. The
corner is lost to logging and fire. Re-established
at proportionate measure between the corner found
1/2 mi. East and the Corner as previously established
at proportionate measure 1/2 mi. West.

**Description of monument and accessories I established to perpetuate the
original location of this corner:**

Set 2-1/2"x30" aluminum pipe with 3-1/2" aluminum cap, stamped as shown
on the **DIAGRAM**, SET 26" in the ground.



From Which:

Ponderosa Pine 8" dia., Bears S47°23'W., 9.0 ft., scribed: 1/4 S27 BT

Ponderosa Pine 14" dia., Bears N 2°02'W., 14.3 ft., scribed: 1/4 S22 BT

Measurements to trees taken with Electronic Tacheometer with bearings
turned from the survey control network.

Nailed a brass washer stamped PLS 848 on blaze above BT scribe, Bearing
Tree Sign above blaze, and warning sign on back of each tree. Painted
a 6" red band at breast ht. around each tree. Set steel fence post with
warning Sign, North 2 ft. from the corner.

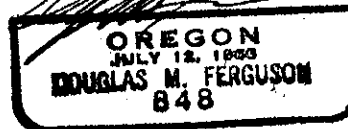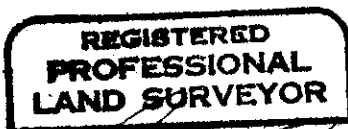

This work is performed by:
Douglas M. Ferguson PLS 848
Mt. Vernon Oregon.
On: Sept. 28, 1988
Refer to Map of Survey No. 10-36-62
Witnesses: D. Mitchell Ferguson & Ken Delano

Office of..... County of.....
State of....., I hereby certify that the within instrument was filed in this office
for record on the..... day of....., 19.....

..... by
(COUNTY OFFICIAL) (DEPUTY)

FILED 3-30-89
BAKER COUNTY SURVEYOR
SURVEY NO. 10-36-93