


CERTIFIED RECORD OF LAND CORNER MONUMENTATION

INDEX No. S-7

History of original corner establishment:

Baker County Survey Records show no previous establishment of this Cor.

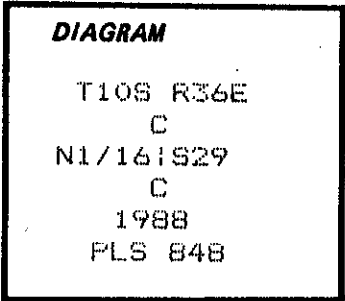

Description of corner evidence found:

Baker County Survey Records show no previous establishment of this Cor.

Description of monument and accessories I established to perpetuate the original location of this corner:

Set 2-1/2"x30" aluminum pipe with 3-1/2" aluminum cap, stamped as shown on the **DIAGRAM**, SET 24" in the ground.

From Which:

Ponderosa Pine 13" dia.,Bears S 1⁰⁰'E., 2.0 ft.,scribed: C-N 1/16 S29 BT

Ponderosa Pine 12" dia.,Bears S40⁰³⁸'W.,25.7 ft.,scribed: C-N 1/16 S19 BT

Measurements to trees taken with Electronic Tacheometer with bearings turned from the survey control network.

Nailed a brass washer stamped PLS 848 on blaze above BT scribe, Bearing Tree Sign above blaze, and warning sign on back of each tree. Painted a 6" red band at breast ht. around each tree. Set steel fence posts with warning & Boundary Signs, East & West 4 ft. from the corner.



This work is performed by:
Douglas M. Ferguson PLS 848
Mt.Vernon Oregon.
On: Nov. 19, 1988
Refer to Map of Survey No. 10-36-64
Witnesses: D.Mitchell Ferguson & Ken Delano

Office of..... County of.....
State of....., I hereby certify that the within instrument was filed in this office
for record on the..... day of....., 19.....
..... by
(COUNTY OFFICIAL) (DEPUTY)

FILED 3-30-89
BAKER COUNTY SURVEYOR
SURVEY NO. 10-36-97