


CERTIFIED RECORD OF LAND CORNER MONUMENTATION

INDEX No. T-17

History of original corner establishment:

Corner was originally established in 1881, by Herman D. Gradon, under General Land Office Contract No. 416. U.S. Surveyor General's Notes State: Set a post 3-1/2 ft. long, 3 ins. square 24 ins. in the ground for 1/4 sec. cor., marked 1/4 S on W face:

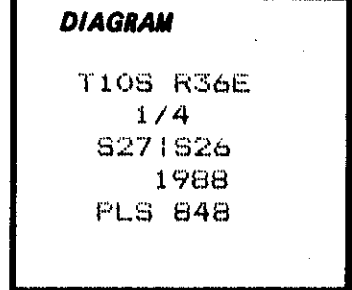

from which:

A pine 40 ins. diam. bears S80°E., 96 lks dist. marked 1/4 S BT
A pine 20 ins. diam. bears N87°W., 66 lks dist. marked 1/4 S BT

Description of corner evidence found:

No trace of the original post is remaining.
The area has been logged at least two times.

There are a number of old stumps and tree remains in the area. There are no ax marks or scribing marks identified. There has been a fire through the area some years ago. There are more than one set of trees which conform to record measure within a reasonable area, however I do not feel there is sufficient evidence to establish the corner position. The corner is therefore set at proportionate measure between the Corners found 1/2 mi. North & South.

Description of monument and accessories I established to perpetuate the original location of this corner:

Set 2-1/2"x30" aluminum pipe with 3-1/2" aluminum cap, stamped as shown on the **DIAGRAM**, SET 27" in the ground.

From Which:

Ponderosa Pine 10" dia., Bears N51°42'E., 18.3 ft., scribed: 1/4 S26 BT
Ponderosa Pine 12" dia., Bears S 6°13'W., 49.5 ft., scribed: 1/4 S27 BT
Measurements to trees taken with Electronic Tacheometer with bearings turned from the survey control network.

Nailed a brass washer stamped PLS 848 on blaze above BT scribe, Bearing Tree Sign above blaze, and warning sign on back of each tree. Painted a 6" red band at breast ht. around each tree. Set steel fence post with warning Sign, North 2 ft. from the corner.



This work is performed by:
Douglas M. Ferguson PLS 848
Mt. Vernon Oregon.
On: Sept. 28, 1988
Refer to Map of Survey No. 10-36-62
Witnesses: D. Mitchell Ferguson & Ken Delano

Office of..... County of.....
State of....., I hereby certify that the within instrument was filed in this office
for record on the..... day of....., 19.....

..... by
(COUNTY OFFICIAL) (DEPUTY)

FILED 3-30-89
BAKER COUNTY SURVEYOR
SURVEY NO. 10-36-115