

CERTIFIED RECORD OF LAND CORNER MONUMENTATION

INDEX No. Z-19

History of original corner establishment:

Corner was originally established in 1881, by Eugene P. McCornack, Under General Land Office Contract No. 398. In 1974, the Bureau of Land Management Remonumented this corner as based on the recovery of original evidence. Such remonumentation is shown in the official BLM Notes, Titled "REMONUMENTATION OF CERTAIN ORIGINAL CORNER POINTS, TOWNSHIP 10 SOUTH, RANGE 36 EAST. Work was executed by: Lester E. Fischer, Cadastral Surveyor, Under special instructions dated May 3, 1957, approved May 6, 1957, under U.S. Survey/Group Number 350, and assignment instructions dated Sept. 13, 1974.

DIAGRAM

SC
T10S R36E
1/4 S35

1974

Description of corner evidence found:

Found 2-1/2" iron pipe with 3" brass cap stamped as shown in the diagram, in a poorly constructed and deteriorated mound of stone.


Found both Bearing Trees as taken by the Bureau of Land Management, in good condition.

Description of monument and accessories I established to perpetuate the original location of this corner:

The above described iron pipe & brass cap are in proper position, reconstructed a mound of stone around such monument.

From Which:

The Trees as taken by the Bureau of Land Management have the proper signs and are painted with a 6" red band at breast height.

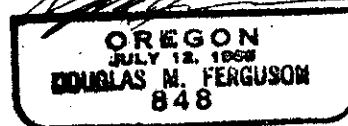

This work is performed by:
Douglas M. Ferguson PLS 848
Mt. Vernon Oregon.
On: Sept. 8, 1988
Refer to Map of Survey No. 10-36-61
Witnesses: D. Mitchell Ferguson & Ken Delano

Office of..... County of.....
State of....., I hereby certify that the within instrument was filed in this office
for record on the..... day of....., 19....

..... by
(COUNTY OFFICIAL) (DEPUTY)

FILED 3-30-89
BAKER COUNTY SURVEYOR
SURVEY NO. 10-36-159