

CERTIFIED RECORD OF LAND CORNER MONUMENTATION

L-9

History of original corner establishment:

Corner originally established in 1881 by Herman D. Gradon, U. S. Deputy Surveyor, under GLO Contract No. 416 dated August 19, 1881. Surveyor General records state:

At the corner position a 3' long by 3" square post was set 24" in the ground, marked 1/4 S on West face from which:

A 20" Pine bears S80°E 27 links marked 1/4 S BT.


A 16" Pine bears N86°W 33 links marked 1/4 S BT.

In 1986 William R. Wells (PLS 1106) was unable to find any evidence of original corner. He re-established corner location by single proportional measurement between the Northeast and Southeast corners of Section 17 and set a 2 1/2" by 30" aluminum pipe with 2 1/2" aluminum cap 24" in the ground, marked as shown in corner diagram, surrounded by mound of earth and a few stones from which:

A 12" Western Larch bears N86 1/2°W, 49.6' scribed 1/4 S17 BT.

An 11" Ponderosa Pine bears N37 1/2°E, 35.3' scribed 1/4 S16 BT.

New bearing trees have a brass washer stamped PLS 1106 nailed to face of blaze. Painted face of blaze and a 6" red band around each bearing tree. Set steel fenceposts North and South of corner with 54-9 sign on one and 54-2 signs on both.

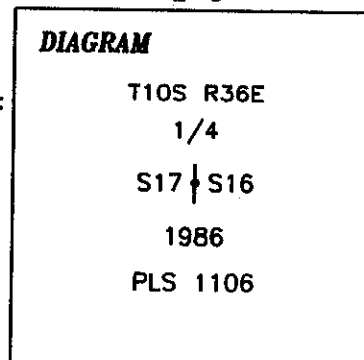

Description of corner evidence found:

2 1/2" Aluminum cap 4" above the ground marked as shown in corner diagram from which:

17" Western Larch, with healed blaze, bears N86 1/2°W, 49.6' distance.

14" Ponderosa Pine, with visible scribing, bears N37 1/2°E, 35.3' distance.

Steel fenceposts North and South of corner with 54-9 sign on one and 54-2 signs on both.

Description of monument and accessories I established to perpetuate the original location of this corner:

Built small stone mound around corner monument.

New bearing trees established:

12" Ponderosa Pine bears S70°E, 46.9' distance, scribed 1/4 S16 BT.



12" Ponderosa Pine bears S33°W, 16.6' distance, scribed 1/4 S17 BT.

New bearing trees have a brass washer stamped PLS 2672 nailed to face of blaze. Attached 54-3 and 54-9 signs to each bearing tree and painted face of blaze and a 6" band around each bearing tree. The distance is measured to a 50d nail in side center of bearing trees.

Compass declination 18° East.

Date: October 21, 1997

Witnessed by: Yvonne Santiago

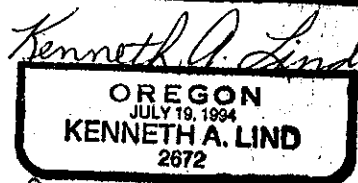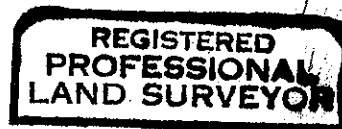

Renews 12-31-98

Office of.....County Surveyor..... County of.....Baker.....

State of.....Oregon....., I hereby certify that the within was filed in this office
for record on the..... day of....., 19.....

..... by
(COUNTY OFFICIAL) (DEPUTY)

FILED DEC. 8, 1997

BAKER COUNTY SURVEYOR

SURVEY NO. 10-36-161