

CERTIFIED RECORD OF LAND CORNER MONUMENTATION

N-11

History of original corner establishment:

Corner originally established in 1881 by Herman D. Gradon, U.S. Deputy Surveyor, under Contract No. 416. Surveyor General records state: Set a post 3 ft. long, 3 ins square, 24 ins in the ground, for 1/4 sec. cor. marked 1/4 S on N. face, from which:


- A pine 36 ins diam. bears N60°W 49 lks dist. marked 1/4 S BT.
- A pine 40 ins diam. bears S75°E 114 lks dist. marked 1/4 S BT.

In 1918 USFS Surveyor S. Simms set a basalt stone 15 x 12 x 5 ins. 8 ins. in the ground in a mound of stone 2 ft. base, 6 ins. high marked 1/4 on N. face from which the remains of the original bearing trees:

- 24" ponderosa pine stump bears N60°W, 49 lks. dist with visible scribing.
- Indeterminate size ponderosa pine stump bears S75°E, 114 lks. dist. with no visible scribing.

In 1974 the BLM set at the corner point an iron post, 28 ins. long, 2 1/2 ins. diam., 22 ins. in the ground, and in a mound of stone, 2 ft. base to top, with brass cap marked as shown in corner diagram from which:

- A ponderosa pine, 10 ins. diam., bears N56°W, 61 lks. dist., mkd. 1/4 S16 BT.
  - A ponderosa pine, 6 ins. diam., bears S55°W, 36 lks. dist., mkd. 1/4 S21 BT.
- The corner stone was buried alongside iron post.

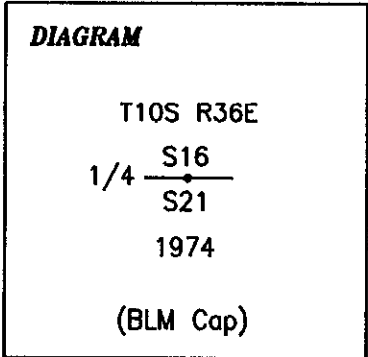

Description of corner evidence found:

- 3 1/4" Brass cap 5" above the ground in stone mound marked as shown in corner diagram from which:
- 15" Ponderosa Pine, with healed blaze, bears N56°W, 61 links distance.
- 10" Ponderosa Pine, with healed blaze, bears S55°W, 36 links distance.

Steel fenceposts 2.8' West with 54-2 sign, 2.3' East with 54-2 sign, and 2.9' South with 54-9 sign.

Corner is 10' South of East-West fenceline.

Description of monument and accessories I established to perpetuate the original location of this corner:

New bearing trees established:

- 17" Ponderosa Pine bears N45°E 47.0' distance scribed 1/4 S16 BT.
- 11" Ponderosa Pine bears S26°E 61.2' distance scribed 1/4 S21 BT.

New bearing trees have a brass washer stamped PLS 2672 nailed to face of blaze. Attached 54-3 and 54-9 signs to each bearing tree and painted face of blaze and a 6" band around each bearing tree. The distance is measured to a 50d nail in side center of bearing trees.

Compass declination 18' East.

Date: October 29, 1997

Witness: Yvonne Santiago



*Kenneth A. Lind*

OREGON  
JULY 18, 1994  
KENNETH A. LIND  
2072

Renews 12-31-98

Office of.....County Surveyor..... County of.....Baker.....  
State of.....Oregon....., I hereby certify that the within was filed in this office  
for record on the..... day of....., 19.....

..... by .....  
(COUNTY OFFICIAL) (DEPUTY)