

CERTIFIED RECORD OF LAND CORNER MONUMENTATION

P-11

History of original corner establishment:

Corner established in 1988 by Douglas M. Ferguson, Oregon Registered Professional Land Surveyor 848, as part of the Whitney Cadastral Survey project for the U. S. Forest Service, Contract No. 53-04M3-7-03252. Survey is filed with the Baker County Surveyor as Survey No. 10-36-62.

Set 2" x 30" iron pipe with 3 1/4" aluminum cap stamped as shown in corner diagram from which:

- A Ponderosa Pine 12" dia., Bears N00°37'W, 105.8 ft., scribed C1/4 S21 BT
- A Ponderosa Pine 18" dia., Bears N62°25'W, 163.0 ft., scribed C1/4 S21 BT

DIAGRAM

T10S R36E

C1/4 • S21

1988

PLS 848

Description of corner evidence found:

- 3 1/4" Aluminum cap 2" above the ground marked as shown in corner diagram from which:
- 11" Ponderosa Pine, with visible scribing, bears N11°E (Record N00°37'W) 105.8' dist.
- 16" Ponderosa Pine, with visible scribing, bears N54°W (Record N62°25'W) 163.0' dist.

Corner is in the barnyard of the Hale Ranch and is located 3.8' from NW corner of bunkhouse.

Description of monument and accessories I established to perpetuate the original location of this corner:


- Set 5/8" by 30" rebar with 1 1/2" aluminum cap marked Azimuth Point PLS 2672 1997.
- Azimuth point bears N30°47'33"E, 329.69' distance from C1/4 S21.
- Built stone mound around Azimuth Point and installed 54-9 sign on nearby tree.

Did not paint or flag bearing trees due to their close proximity to the Hale Ranch.
No suitable trees in South quadrants.


Compass declination 18° East.

Date: October 29, 1997

Witness: Yvonne Santiago

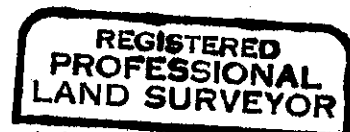

Kenneth A. Lind

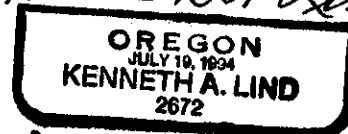

Renews 12-31-98

Office of.....County Surveyor..... County of.....Baker.....

State of.....Oregon....., I hereby certify that the within was filed in this office
for record on the..... day of....., 19.....

..... by
(COUNTY OFFICIAL) (DEPUTY)