

CERTIFIED RECORD OF LAND CORNER MONUMENTATION

History of original corner establishment:

Corner was established by William R. Gradon, US Deputy Surveyor, during the original survey Contract No. 409 dated March, 1882.

"Set a post 3 ft. long, 3 ins square 24 ins in the ground, for 1/4 sec. cor., marked 1/4S on W. face, from which:

A pine 10 ins diam. bears N40°E, 60 lks dist, marked 1/4S BT.

A pine 24 ins diam. bears N54°W, 15 lks dist, marked 1/4S BT."

In 1971 the Bureau of Land Management monumented the corner as follows:

"The 1/4 sec. cor. of secs. 8 and 9, determined at record bearing and distance from the remains of the original bearing trees:

A pine, 18 ins. diam., bears N40°E, 60 lks. dist., with scribe marks 1/4 S BT visible on partially opened blaze.

A decayed pine stump, size indeterminate, bears N54°W, 15 lks. dist., no marks visible.

At the corner point set an iron post 28 ins. long, 2 1/2 ins, diam., 24 ins. in the ground, with brass cap mkd. as shown on diagram,

from which new bearing trees:

A ponderosa pine, 10 ins. diam., bears N60°E, 61 lks. dist., mkd. 1/4 S9 BT.

A ponderosa pine, 13 ins. diam., bears S67°W, 52 lks. dist., mkd 1/4 S8 BT.

Bury a granite stone, 6 x 5 x 4 ins., with an X chiseled on W. face, alongside iron post."

DIAGRAM

T10S R37E

1/4

S8 | S9

1971

BLM

Description of corner evidence found:

Found 1971 BLM brass cap in good condition, stamped as shown on diagram, with steel post set alongside, from which:

A 24" Ponderosa Pine, bears N43°E, 33 ft., with blaze opened by others.

A 14" Ponderosa Pine, bears N60°E, 61 lks., with blaze healed over.

A 18" Ponderosa Pine, bears S67°W, 52 lks. with blaze healed over.

Description of monument and accessories I established to perpetuate the original location of this corner:

Maintained corner by attaching "Land Survey Monument" signs to steel post and bearing trees as needed, painting 6" wide red bands around bearing trees, from which new accessories are:

An orange DEEP (Underground Magnetic Locator) N31°W, 2.6 ft. from corner position, 1.1 ft. in ground.


I, Leland Lee Myers, 587 E Auburn Street, PO Box 98, Sumpter, OR 97877, do hereby certify that on June 14, 1994, I maintained the corner as herein described.

FILED IN THE OFFICE OF THE BAKER COUNTY SURVEYOR THIS
____ DAY OF _____, 1995.

10-37-46

Baker County Surveyor

Client: US Forest Service

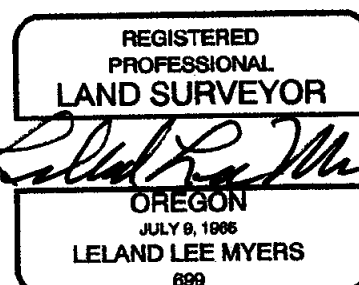

Renewal Date 1/1/97

T10S R37E G-9