

**CERTIFIED RECORD OF LAND CORNER MONUMENTATION**

History of original corner establishment:

Not previously set.

**DIAGRAM**

**T10S R37E**

**C1/4 + S10**

**1994  
PLS699**

Description of corner evidence found:

Corner is being set by this survey.

Description of monument and accessories I established to perpetuate the original location of this corner:

Set 2" aluminum pipe with 3 1/4" aluminum cap, stamped as shown in diagram, 24" in ground, at a point as determined by the procedures set forth in the MANUAL OF INSTRUCTIONS FOR THE SURVEY OF PUBLIC LANDS for the subdivision of sections, in mound of rock 24" base, 4" high, corner falls in a dredge pond that is nearly silted in and is full of cattails, from which new accessories are:

A No. 5 rebar with yellow plastic cap stamped "PLS699", bears S11°10'E, 49.81 ft.

A No. 5 rebar with yellow plastic cap stamped "PLS699", bears N83°E, 112.62 ft.

No trees were available and other references were not practical. The bearing and distance between reference monuments is N62°43'20"W, 136.58 feet.

Also set galvanized steel post with "Land Survey Monument" sign 3 ft. N.


I, Leland Lee Myers, 587 E Auburn Street, PO Box 98, Sumpter, OR 97877, do hereby certify that on July 11, 1994, I monumented the corner as herein described.

FILED IN THE OFFICE OF THE BAKER COUNTY SURVEYOR THIS  
7 DAY OF Feb, 1995.

10-37-50

**Baker County Surveyor**

Client: Warnock Ranches, Lyle Defrees & US Forest Service

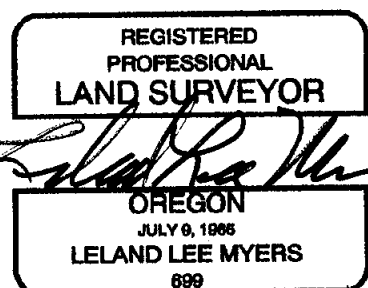

Renewal Date 1/1/97

**T10S R37E G-15**