

CERTIFIED RECORD OF LAND CORNER MONUMENTATION

History of original corner establishment:

Corner was established by William R. Gradon, US Deputy Surveyor, during the original survey Contract No. 409 dated March, 1882.

"Set a basalt stone 20 x 10 x 5 ins, 15 ins in the ground, for 1/4 sec. cor., marked 1/4 on N face, from which:

A tamarack 15 ins diam. bears N35°W, 38 lks dist, marked 1/4S BT.

A Pine 36 ins diam. bears S15°W, 34 lks dist, marked 1/4S BT."

In 1971 the Bureau of Land Management monumented the corner as follows:

"The 1/4 sec. cor. of secs. 9 and 16, monumented with the original basalt stone, 23 x 8 x 4 ins., firmly set 10 ins. in the ground, with faint chisel marks on N. face, from which the remains of the original bearing trees:

A western larch stump, size indeterminate, bears S35°W, 38lks. dist., with illegible scribe marks visible on open blaze.

A pine stump, 36 ins. diam., bears S15°W, 36 lks. dist, with scribe marks BT visible on open blaze. (Record, 34 lks.)

At the corner point set an iron post 28 ins. long, 2 1/2 ins, diam., 24 ins. in the ground, with brass cap mkd. as shown on diagram,

from which new bearing trees:

A fir, 10 ins. diam., bears N20°E, 20 lks. dist., mkd. 1/4 S9 BT.

A fir, 10 ins. diam., bears S2°W, 12 lks. dist., mkd 1/4 S16 BT.

Bury corner stone, to which I add an X chiseled on N. face, alongside iron post."

DIAGRAM

T10S R37E

S 9

1/4

S16

1971

BLM

Description of corner evidence found:

Found 1971 BLM brass cap in good condition, stamped as shown on diagram, with steel post set 1ft. E, from which:

A 15" Douglas Fir bears S2°W, 12 lks. with blaze healed over.

A 15" Douglas Fir bears N20°E, 20 lks. with blaze healed over.

Description of monument and accessories I established to perpetuate the original location of this corner:

Maintained corner by attaching "Land Survey Monument" signs to steel post and bearing trees as needed, painting 6" wide red bands around bearing trees, and by setting new accessories

An orange DEEP (Underground Magnetic Locator) bears N79°W, 2.4 ft., 1.4 ft. in the ground.

A silver DEEP bears S79°E, 2.6 ft, 1.4 ft. in the ground

I, Leland Lee Myers, 587 E Auburn Street, PO Box 98, Sumpter, OR 97877, do hereby certify that on June 15, 1994, I maintained the corner as herein described.


FILED IN THE OFFICE OF THE BAKER COUNTY SURVEYOR THIS

7 DAY OF Feb, 1995.

10-37-58

Baker County Surveyor

Client: US Forest Service

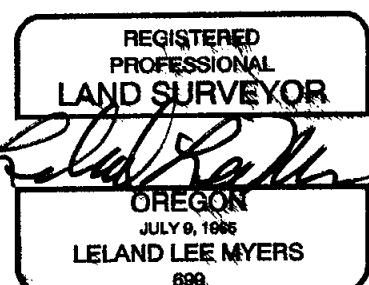

Renewal Date 1/1/97

T10S R37E J-11