

CERTIFIED RECORD OF LAND CORNER MONUMENTATION

History of original corner establishment:

Corner was established by William R. Gradon, US Deputy Surveyor, during the original survey Contract No. 409 dated March, 1882.

"Set a post 3 ft. long, 3 ins square 24 ins in the ground, for 1/4 sec. cor., marked 1/4S on N face, from which:

A Pine 24 ins diam. bears N35°E, 74lks dist, marked 1/4S BT.

A Pine 20 ins diam. bears S40°W, 58 lks dist, marked 1/4S BT."

DIAGRAM

T10S R37E

S10

1/4

S15

1994

PLS 699

Description of corner evidence found:

Found one original 18" BT stump with a partial blaze at S40°W, 58 lks.

Description of monument and accessories I established to perpetuate the original location of this corner:

Set 2" aluminum pipe with 3 1/4" aluminum cap, stamped as shown in diagram, 28" in ground from the BT remains, from which new accessories are:

A 13" Ponderosa Pine bears S73°W, 45.5 ft, scribed 1/4 S15 BT.

A 9" Ponderosa Pine bears N21°W, 20.3 ft., scribed 1/4 S10 BT.

A clear with blue ribbon DEEP (Underground Magnetic Locator) bears N73°E, 2.2 feet, 1.7 feet in the ground.

A clear with red ribbon DEEP bears S21°E, 2.0 feet, 2.0 feet in the ground.

I, Leland Lee Myers, 587 E Auburn Street, PO Box 98, Sumpter, OR 97877, do hereby certify that on July 11, 1994, I monumented the corner as herein described.



FILED IN THE OFFICE OF THE BAKER COUNTY SURVEYOR THIS

7 DAY OF Feb, 1995.

10-37-60

Baker County Surveyor

Client: Lyle Defrees & US Forest Service

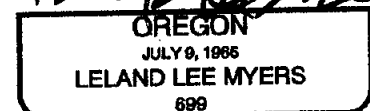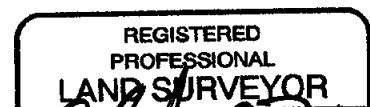

Renewal Date 1/1/97

T10S R37E J-15