


CERTIFIED RECORD OF LAND CORNER

History of original corner establishment:

Not previously set.

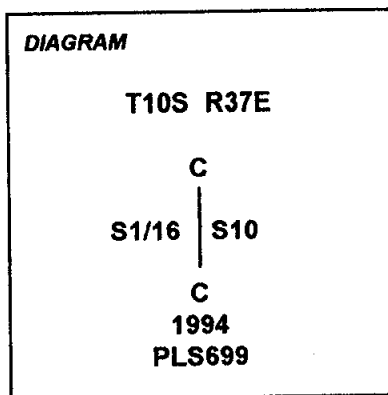

Description of corner evidence found:

Corner is being set by this survey.

Description of monument and accessories I established to perpetuate the original location of this corner:

Set 2" aluminum pipe with 3 1/4" aluminum cap, stamped as shown in diagram, 28" in ground, at a point as determined by the procedures set forth in the MANUAL OF INSTRUCTIONS FOR THE SURVEY OF PUBLIC LANDS for the subdivision of sections, from which new accessories are:

An 11" Western Larch, bears S68°40'W, 15.26 ft., scribed "CN1/16 S26 BT"

A 13" Western Larch, bears N20°45'E, 29.45 ft., scribed "CN1/16 S26 BT"

Also set galvanized steel posts with "Property Boundary" and "Land Survey Monument" sign 5 ft. E. and "Property Boundary" sign 5 ft. N..

I, Leland Lee Myers, 587 E Auburn Street, PO Box 98, Sumpter, OR 97877, do hereby certify that on November 19, 1994, I monumented the corner as herein described.

FILED IN THE OFFICE OF THE BAKER COUNTY SURVEYOR THIS

7 DAY OF Feb, 1995.

10-37-65

Baker County Surveyor

Client: Lyle Defrees & US Forest Service



Renewal Date 1/1/97

