

# CERTIFIED RECORD OF LAND CORNER MONUMENTATION

## History of original corner establishment:

Corner was established by William R. Gradon, US Deputy Surveyor, during the original survey Contract No. 409 dated March, 1882.

"Set a basalt stone 17 x 11 x 4 ins 11 ins in the ground, for 1/4 sec. cor., marked 1/4S on N face, from which:

A tamarack 12 ins diam. bears N10°E 52 lks dist, marked 1/4S BT.  
A fir 24 ins diam. bears S40°W, 47 lks dist, marked 1/4S BT."

In 1971 the Bureau of Land Management monumented the corner as follows:

"The 1/4 sec. cor. of secs. 26 and 35, monumented with the original basalt stone, 12x 10 x 4, now broken, firmly set 8 ins. below the surface of the ground, mkd. 1/4 on N. face, from which the remains of the original bearing trees:

A western larch, 16 ins. diam., bears N15°E, 52 lks. dist., with scribe marks 1/4 S BT visible on open blaze.  
(Record N10°E.)

A fir, 40 ins. diam., bears S25°W, 47 lks. dist., with healed blaze. (Record S50°W.)

At the corner point set an iron post 28 ins. long, 2½ ins. diam., 22 ins. in the ground, with brass cap mkd. as shown on diagram,

from which new bearing trees:

A fir, 10 ins. diam., bears South, 36 lks. dist., mkd. 1/4 S35 BT.

A fir, 10 ins. diam., bears N16°W, 47 lks. dist., mkd 1/4 S26BT.

Bury corner stone and deposit a glass bottle alongside iron post."

## DIAGRAM

T10S R37E

S23

1/4

S26

1971

BLM

## Description of corner evidence found:

Found 1971 BLM brass cap in good condition, stamped as shown on diagram, with steel post set 3 ft. W, from which:

A 40" White Fir, bears S25°W, 47 lks. with blaze healed over, dead due to fire.

## Description of monument and accessories I established to perpetuate the original location of this corner:

Maintained corner by attaching "Land Survey Monument" signs to steel post and bearing trees as needed, painting 6" wide red bands around bearing trees, and making new accessories:

A 16" Ponderosa Pine, bears N76°50'E, 146.5ft., scribed "1/4 S35 BT".

A 19" Western Larch, bears N25°50'E, 125.8 ft., scribed "1/4 S26 BT".

A blue DEEP ( Underground Magnetic Locator ), bears S25°50'W, 2.6 ft., 0.5 ft. in ground.

An orange DEEP, bears S76°50'W, 3.6 ft., 0.9 ft. in ground

The corner location is in an area badly burned by a forest fire and there were no live trees available to the south and west of the corner location.

I, Leland Lee Myers, 587 E Auburn Street, PO Box 98, Sumpter, OR 97877, do hereby certify that on November 21, 1994, I maintained the corner as herein described.


FILED IN THE OFFICE OF THE BAKER COUNTY SURVEYOR THIS

7 DAY OF Feb, 1995.

10-37-72

Baker County Surveyor

Client: Lyle Defrees & US Forest Service

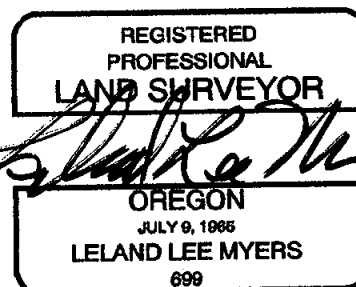

Renewal Date 1/1/97

T10S R37E V-19