


10-37-75

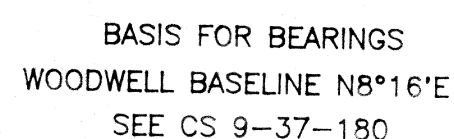

(.....)



The purpose of this survey was to subdivide, monument the property corners and mark the National Forest boundary lines in the SW1/4NE1/4, W1/2, and SE1/4 of Section 26 and the north half of the line between Sections 35 & 36, T10S, R37E, WM, all in Baker County, Oregon, as a cooperative survey for USDA--Forest Service and Lyle Defrees.

This survey is tied to other surveys I have done this past year in Sumpter Valley for the purpose of using a common coordinate system and basis for bearings which I use in the City of Sumpter and the other surveys in Sumpter Valley. In 1971, the Bureau of Land Management monumented a number of the section and quarter corners from found evidence which was established in 1882 by William Graden during Contract No. 409 for the survey of the township.

The basis for bearings is the Woodwell Base Line on Mill Street in Sumpter. The base line was established by Art Woodwell, an early surveyor in Sumpter from around 1920 until about 1960, many years ago as control for surveys in Sumpter. The original plots of Sumpter use N81°E as the bearing line. Art Woodwell told me he had done a Polaris shot on the line and came up with the same bearing. I have used this bearing for a number of surveys over many years.

I found no unusual irregularities in the survey of the township. The west quarter corner had not been previously monumented from found evidence. Using the control survey to isolate the corner location, I found two stump holes at the proper positions for the bearing trees. Whereas the corner position I based on the stump holes is less than twenty feet from the proportioned position, I accepted the stump holes as evidence of the corner.

I, Leland Lee Myers, a Professional Land Surveyor registered in the State of Oregon, 587 E Auburn Street, PO Box 98, Sumpter, Oregon 97877, completed this survey on November 15, 1994, by setting the monuments and do hereby certify that the information shown on this plat is correct to the best of my knowledge.

Renewal Date 1/1/97

EXAMINED AND ACCEPTED FOR THE US FOREST SERVICE  
THIS 6th DAY OF FEBRUARY, 1995.  
Roger Green COR  
I CERTIFY THAT THIS SURVEY WAS PERFORMED AT THE  
REQUEST OF THE WALLOWA-WHITMAN NATIONAL FOREST  
AS A COOPERATIVE SURVEY WITH LYLE DEFREES.  
Roger Green 2/6/95  
FOREST SUPERVISOR DATE