

CERTIFIED RECORD OF LAND CORNER MONUMENTATION


History of original corner establishment:

William R. Graddon, U.S. Cadastral Surveyor
July 1, 1882

40.00 Set a post 3 ft. long, 3 ins. square, 24 ins. in the ground for $\frac{1}{4}$ sec. cor. marked $\frac{1}{4}$ S on W. face, from which:

A fir, 30 ins. diam., bears S.35°E., 14 lks. dist., mkd. $\frac{1}{4}$ SBT.
A fir, 6 ins. diam., bears N.40°W., 13 lks. dist., mkd. $\frac{1}{4}$ SBT.

Owen C. Chatters, II and Lester E. Fisher, Cadastral Surveyors
July 26, 1974

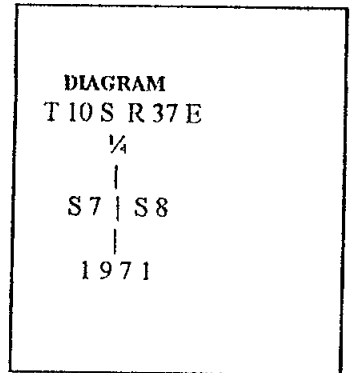

The $\frac{1}{4}$ sec. cor. of secs. 7 and 8, determined at record bearing and distance from the remains of the original bearing trees:

A root hole, bears S.35°E., 14 lks. dist., with a down fir alongside, 32 ins. diam., no marks visible.
A fir, 16 ins. diam., bears N.40°W., 13 lks. dist., mkd. $\frac{1}{4}$ S BT visible on open blaze.

At the corner point

Set an iron post, 28 ins. long, 2½ ins. diam., 24 ins. in the ground, with brass cap, from which new bearing trees:

A fir, 11 ins. diam., bears S.27°W., 43 lks. dist., mkd. $\frac{1}{4}$ S7 BT.
A fir, 7 ins. diam., bears N.57°E., 10½ lks. dist., mkd. $\frac{1}{4}$ S8 BT.

Bury a basalt stone, 7 x 4 x 4 ins., with an X chiseled on W. face, and deposit a glass bottle alongside iron post.

Description of corner evidence found:

Found a 2½" BLM brass cap, 4" out of the ground, in a small mound of stone, from which:

A fir, 14" diam., bears S.27°57'W., 27.6', scribed " $\frac{1}{4}$ S7BT".
A fir, 12" diam., bears N.54°44'E., 6.5', scribed " $\frac{1}{4}$ S8BT".

Description of monument and accessories I established to perpetuate the original location of this corner:

A fir, 14" in diam., bears N.38°55'W., 9 ft., double blazed and scribed " $\frac{1}{4}$ S7BT" with nail and brass washer "RLS 1060", on face of blaze.
A 5/8" x 18" rebar, bears S.36°39'E., 13.3 ft. with brass washer "RLS 1060".

Office of _____ County of _____
State of _____ I hereby certify that the within instrument was filed in this office
for record on the ____ day of _____, 19____
_____ by _____

(COUNTY OFFICIAL)

(DEPUTY)

REGISTERED
PROFESSIONAL
LAND SURVEYOR

R. David Schurian 7-15-96

OREGON
JUNE 18, 1976
R. DAVID SCHURIAN
1060