


# CERTIFIED RECORD OF LAND CORNER MONUMENTATION

## History of original corner establishment:

According to a plat filed at the Baker County Surveyors Office on June 29, 1994, survey number 10-37-37. Surveyed by Hanley Engineering for Evan Hale on April 2- June 15, 1994.

Set 5/8" x 30" rebar and plastic cap marked " HANLEY ENGRG PLS 1206"

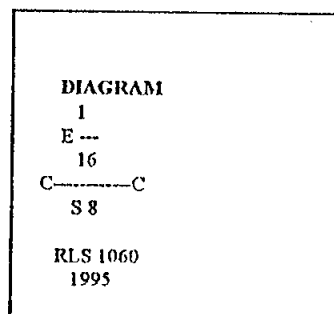

## Description of corner evidence found:

Found a 5/8" x 30" rebar with a yellow plastic cap, marked "HANLEY ENGR. PLS 1206".

## Description of monument and accessories I established to perpetuate the original location of this corner:

At the rebar position, set a USFS 3/4" aluminum capped monument 20" in the ground, with a small mound of stone to cap, rebar set inside the pipe, from which:

A fir, 10" in diam., bears S.30°30'W., 19.3 ft., double blazed and scribed "CE1/16S8BT" with nail and brass washer "RLS 1060", on face of blaze.

A tamarack, 13" in diam., bears N.61°30'W., 14.1 ft., double blazed and scribed "CE1/16S8BT" with nail and brass washer "RLS 1060", on face of blaze.

REGISTERED  
PROFESSIONAL  
LAND SURVEYOR

*R. David Schurian* 7-15-96

OREGON  
JUNE 18, 1976  
R. DAVID SCHURIAN  
1060

Office of \_\_\_\_\_ County of \_\_\_\_\_  
State of \_\_\_\_\_ I hereby certify that the within instrument was filed in this office  
for record on the \_\_\_\_ day of \_\_\_\_\_, 19\_\_\_\_  
\_\_\_\_\_ by \_\_\_\_\_

(COUNTY OFFICIAL)

(DEPUTY)

G-8

FILED 7-15-96

BAKER COUNTY SURVEYOR

SURVEY NO. 10-37-87