


CERTIFIED RECORD OF LAND CORNER MONUMENTATION

History of original corner establishment:

According to a plat filed at the Baker County Surveyors Office on June 29, 1994, survey number 10-37-37. Surveyed by Hanley Engineering for Evan Hale on April 2- June 15, 1994.

Set 5/8" x 30" rebar and plastic cap marked " HANLEY ENGRG PLS 1206"

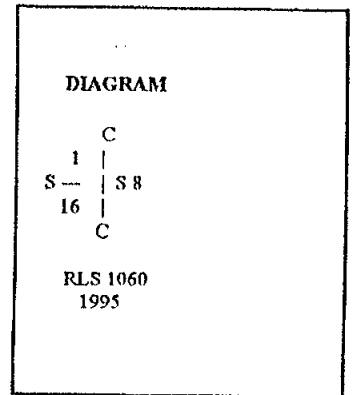

Description of corner evidence found:

Found a 5/8" x 30" rebar with a yellow plastic cap, marked "HANLEY ENGR. PLS 1206".

Description of monument and accessories I established to perpetuate the original location of this corner:

At the rebar position, set a USFS 3/4" aluminum capped monument 15" in the ground, with a small mound of stone around the base, from which:

A fir, 6" in diam., bears S.11°30'E., 71.9 ft., double blazed and scribed "CS1/16S8BT" with nail and brass washer "RLS 1060", on face of blaze.
A fir, 6" in diam., bears N.79°30'E., 25.9 ft., double blazed and scribed "CS1/16S8BT" with nail and brass washer "RLS 1060", on face of blaze.

REGISTERED
PROFESSIONAL
LAND SURVEYOR

R. David Schurian 7-15-96

OREGON
JUNE 18, 1976
R. DAVID SCHURIAN
1060

Office of _____ County of _____
State of _____ I hereby certify that the within instrument was filed in this office
for record on the ____ day of _____, 19____
_____ by _____

(COUNTY OFFICIAL)

(DEPUTY)

H-7

FILED 7-15-96
BAKER COUNTY SURVEYOR
SURVEY NO. 10-37-89