

CERTIFIED RECORD OF LAND CORNER MONUMENTATION

History of original corner establishment:

William R. Gradon, U.S. Deputy Surveyor
July 1, 1882

40.00 Set a basalt stone 10x8x8 ins. 7 ins in the ground for $\frac{1}{4}$ sec.
cor. marked $\frac{1}{4}$ on W. face, from which:

- A pine, 18 ins. diam., bears N.20°E., 68 lks. dist., mkd. $\frac{1}{4}$ SBT.
- A pine, 24 ins. diam., bears N.85°W., 47 lks. dist., mkd. $\frac{1}{4}$ SBT.

Owen C. Chatters, II and Lester E., Fisher, Cadastral Surveyors
July 26, 1974

The $\frac{1}{4}$ sec. cor. of secs. 17 and 18, monumented with the original basalt stone, 13 x 7 x 5 ins., firmly set 4 ins. in the ground, no marks visible, from which original bearing trees:

- A pine, 22 ins. diam., bears N.20°E., 68 lks. dist., with scribe marks $\frac{1}{4}$ S BT visible on open blaze.
- A pine, 26 ins. diam., bears N.85°W., 47 lks. dist., with scribe marks $\frac{1}{4}$ S BT visible on open blaze.

At the corner point

Set an iron post, 28 ins. long, 2 $\frac{1}{2}$ ins. diam., 24 ins. in the ground, with brass cap, from which new bearing trees:

- A ponderosa pine, 11 ins. diam., bears S.75°E., 86 lks. dist., mkd. $\frac{1}{4}$ S17 BT.
- A ponderosa pine, 9 ins. diam., bears N.43°W., 107 lks. dist., mkd. $\frac{1}{4}$ S18 BT.


Bury corner stone, to which I add an X chiseled on W. face along iron post, and raise a mound of stone, 2 ft. base, 1 $\frac{1}{2}$ ft. high, W. of the corner.

Description of corner evidence found:


Found a 2 $\frac{1}{2}$ " BLM brass cap, 4" out of the ground, in a mound of stone to cap from which:

- A pine, 15" diam., bears S.76°09'E., 55.1', scribed " $\frac{1}{4}$ S17BT".
- A pine, 30" diam., bears N.87°45'W., 29.6', scribed " $\frac{1}{4}$ S18BT".
- A pine, 16" diam., bears N.45°30'W., 69.4', scribed " $\frac{1}{4}$ S18BT".
- A pine, 30" diam., bears N.19°45'E., 45', scribed " $\frac{1}{4}$ S17BT".

Description of monument and accessories I established to perpetuate the original location of this corner:

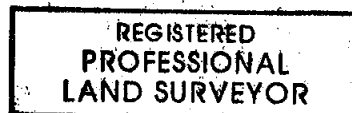

R. David Schurian 7-15-96

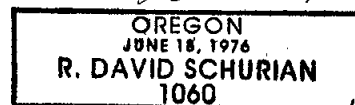

Office of _____ County of _____
State of _____ I hereby certify that the within instrument was filed in this office
for record on the _____ day of _____, 19____
_____ by _____

(COUNTY OFFICIAL)

(DEPUTY)

L-5

FILED 7-15-96
BAKER COUNTY SURVEYOR
SURVEY NO. 10-37-100