

CERTIFIED RECORD OF LAND CORNER MONUMENTATION

History of original corner establishment:

William R. Gradon, U.S. Deputy Surveyor
July 1, 1882

40.00 Set a post 3 ft. long 3 ins. square, 24 ins. in the ground for $\frac{1}{4}$ sec.cor. marked $\frac{1}{4}$ S. on W. face, from which:

- A pine, 6 ins. diam., bears S.40°E., 21 lks. dist. marked $\frac{1}{4}$ SBT
- A tamarack 18 ins. diam., bears S.80°W., 13 lks. dist. marked $\frac{1}{4}$ SBT

Owen C. Chatters, II and Lester E., Fisher, Cadastral Surveyors
July 26, 1974

The $\frac{1}{4}$ sec. cor. of secs. 16 and 17, perpetuated by person(s) unknown, monumented with an iron pipe, 1 $\frac{1}{2}$ ins. diam., firmly set, projecting 12 ins. above ground, with top marked 17|16, from which remains of the original trees:

- A pine, 16 ins. diam., bears S. 40° E., 21 lks. dist., with healed blaze.
- A western larch stump, 18 ins. diam., bears S. 80° W., 13 lks. dist., with scribe marks $\frac{1}{4}$ S BT visible on open blaze.

At the corner point

Set an iron post, 28 ins. long, 2 $\frac{1}{2}$ ins. diam., 24 ins. in the ground.

From which new bearing trees

- A ponderosa pine, 12 ins. diam., bears N. 7° E., 28 lks. dist., mkd. $\frac{1}{4}$ S17 BT.
- A fir, 10 ins. in diam., bears S. 70° W., 49 $\frac{1}{2}$ lks. dist., mkd. $\frac{1}{4}$ S 17 BT.

Insert the iron pipe inside, and bury a blue glass insulator alongside iron post.

Description of corner evidence found:

Found a 3" BLM brass cap, 0.5' above the ground with no stones, from which:

- A snag, 14" in diam., bears S.39°18'E., 13.7', with a scar visible and a BT tag attached.

Description of monument and accessories I established to perpetuate the original location of this corner:


- A pine, 7" in diam., bears S.33°27'E., 38.0 ft., double blazed and scribed " $\frac{1}{4}$ S16 BT" with a brass washer "RLS 1060"nailed to the face of the blaze between the B and T.
- A fir, 9" in diam., bears N.37°55'E., 40.9 ft., double blazed and scribed " $\frac{1}{4}$ S16 BT" with a brass washer "RLS 1060"nailed to the face of the blaze between the B and T.
- A 5/8" x 18" rebar with a 2" aluminum cap, set 16" in the ground, bears S.37°37'W., 16.3' dist., marked "T10SR37E S 16 RM RLS 1060 1996" with an arrow and the bearing and distance to the monument
- A 5/8" x 18" rebar with a 2" aluminum cap, set 17" in the ground, bears N.33°07'W., 20.2' dist., marked "T10SR37E S16 RM RLS 1060 1996" with an arrow and the bearing and distance to the monument

Office of _____ County of _____
State of _____ I hereby certify that the within instrument was filed in this office
for record on the ____ day of _____, 19____
_____ by _____

(COUNTY OFFICIAL)

(DEPUTY)

L-9

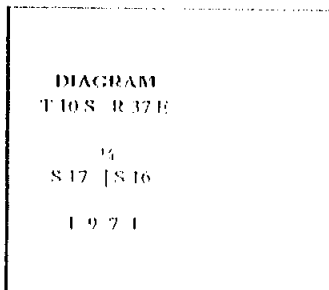

REGISTERED
PROFESSIONAL
LAND SURVEYOR

R. David Schurian 7-15-96

OREGON
JUNE 18, 1976
R. DAVID SCHURIAN
1060

FILED 7-15-96

BAKER COUNTY SURVEYOR

SURVEY NO. 10-37-104