


CERTIFIED RECORD OF LAND CORNER MONUMENTATION

History of original corner establishment:

Not previously set.

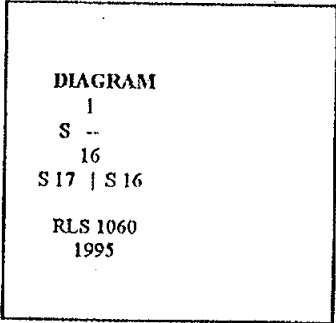

Description of corner evidence found:

Corner is being set this survey.

Description of monument and accessories I established to perpetuate the original location of this corner:

At the point, determined by the procedures in the MANUAL OF INSTRUCTION FOR THE SURVEY OF PUBLIC LANDS, set a USFS 3¼" aluminum capped monument 18" in the ground, with no stones, from which:

- A pine, 18" in diam., bears S.18°50'W., 37.4 ft., double blazed and scribed "S1/16S17BT" with nail and brass washer "RLS 1060", on face of blaze.
- A pine, 9" in diam., bears S.75°30'E., 57.7 ft., double blazed and scribed "S1/16S16BT" with nail and brass washer "RLS 1060", on face of blaze.

REGISTERED
PROFESSIONAL
LAND SURVEYOR

R. David Schurian 7-15-96

OREGON
JUNE 18, 1976
R. DAVID SCHURIAN
1060

Office of _____ County of _____
State of _____ I hereby certify that the within instrument was filed in this office
for record on the ____ day of _____, 19____
_____ by _____

(COUNTY OFFICIAL) (DEPUTY)