

CERTIFIED RECORD OF LAND CORNER MONUMENTATION

History of original corner establishment:

Corner was established by William R. Gradon, US Deputy Surveyor, during the original survey Contract No. 409 dated March, 1882.

"Set a post 4 ft long, 4 ins square 24 ins in the ground, for cor. to secs 2,3,10&11, marked T10S, S2 on NE, R37E, S11 on SE, S10 on SW and S3 on NW faces, with 5 notches on S and 2 notches on E edges, from which:

- A pine 36 ins diam. bears N50°E, 134 lks dist, marked T10S R37E S2 BT.
- A pine 36 ins diam. bears S35°E, 129 lks dist, marked T10S R37E S11 BT.
- A pine 12 ins diam. bears S10°W, 54 lks dist, marked T10S R37E S10 BT."
- A pine 36 ins diam. bears N5°W, 113 lks dist, marked T10S R37E S3 BT.

In 1971 the Bureau of Land Management monumented the corner as follows:

"The cor. of secs. 2, 3, 10, and 11, perpetuated by person(s) unknown, monumented with an iron rod, 1 in. diam., projecting 6 ins. above ground, and in a mound of stone, 3 ft. base, 6 ins. high, from which the remains of the original bearing trees:

A pine stump, 38 ins. diam., bears N5°W, 113 lks. dist., with scribe marks BT visible on open blaze.

At the corner point set an iron post 28 ins. long, 2 1/2 ins, diam., 22 ins. in the ground, to bedrock, and in a collar of stone, 3 ft. base, to top, with brass cap mkd. as shown on diagram, from which new bearing trees:

- A ponderosa pine, 12ins. diam., bears N60°E, 75 lks. dist., mkd. T10S R37E S2 BT.
 - A ponderosa pine, 12 ins. diam., bears S49°E, 50 lks. dist., mkd T10S R37E S11 BT.
 - A ponderosa pine, 8 ins. diam., bears S30°W, 23 lks. dist., mkd. 1T10S R37E S10 BT.
 - A ponderosa pine, 11 ins. diam., bears N17°W, 44½ lks. dist., mkd T10S R37E S3 BT.
- Bury a granite stone, 9x7x5 ins., with an X chiseled on W face and reset the iron rod alongside iron post."

DIAGRAM

T10S R37E

S 3 | S 2

S10 | S11

**1971
BLM**

Description of corner evidence found:

Found 1971 BLM brass cap in good condition, stamped as shown on diagram, with steel post set 1 ft. N, from which:

- A 13" Ponderosa Pine in good condition bears at record, with scribing still visible.
- A 13" Ponderosa Pine in good condition bears at record, with blaze healed over.
- A 11" Ponderosa Pine in good condition bears at record, with blaze healed over.
- A 14" Ponderosa Pine in good condition bears at record, with scribing still visible.

Description of monument and accessories established to perpetuate the original location of this corner:

Maintained corner by attaching "Land Survey Monument" signs to steel post and bearing trees as needed, and painting 6" wide red bands around bearing trees.


I, Leland Lee Myers, 587 E Auburn Street, PO Box 98, Sumpter, OR 97877, do hereby certify that on July 14, 1994, I maintained the corner as herein described.

FILED IN THE OFFICE OF THE BAKER COUNTY SURVEYOR THIS
7 DAY OF Feb, 1995.

10-37-42

Baker County Surveyor

Client: Warnock Ranches. Lvlle Defrees & US Forest Service

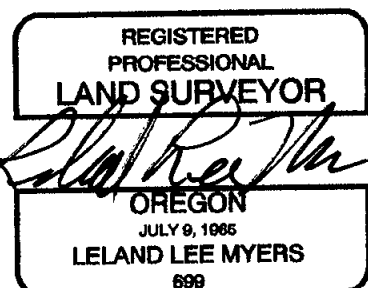

Renewal Date 1/1/97

T10S R37E E-17