

CERTIFIED RECORD OF LAND CORNER MONUMENTATION

History of original corner establishment:

Corner was established by William R. Gradon, US Deputy Surveyor, during the original survey Contract No. 409 dated March, 1882.

"Set a post 3 ft. long, 3 ins square 12 ins in the ground, for 1/4 sec. cor., marked 1/4S on W. face, from which, dug pits 18 x 18 x 12 ins. N. and S. of cor., 5 1/2 ft. dist., and raised a mound of earth 1 1/2 ft. high, 3 1/2 ft. base around post.

DIAGRAM

T10S R37E

1/4

S10 | S11

1994

PLS699

Description of corner evidence found:

This corner location falls in the dredge tailings, so there is no evidence of the original corner.

Description of monument and accessories I established to perpetuate the original location of this corner:

Set 2" aluminum pipe with 3 1/4" aluminum cap, stamped as shown in diagram, 27" in ground, by single proportion, from which new accessories are:

An 8" Willow, bears S69°25'E, 14.42 ft., scribed "1/4 S11 BT".

A No. 5 rebar with yellow plastic cap stamped "PLS699", bears S37°25'W, 90.58 ft.

An orange DEEP (Underground Magnetic Locator), bears N69°30'E, 2.55 ft. from corner position, 1.2 ft. in ground.

A blue DEEP, bears N37°E, 2.35 ft. from corner position, 1.4 ft. in ground.

No other trees were available.

I, Leland Lee Myers, 587 E Auburn Street, PO Box 98, Sumpter, OR 97877, do hereby certify that on July 14, 1994, I monumented the corner as herein described.


FILED IN THE OFFICE OF THE BAKER COUNTY SURVEYOR THIS

7 DAY OF Feb, 1995.

10-37-51

Baker County Surveyor

Client: Warnock Ranches, Lyle Defrees & US Forest Service

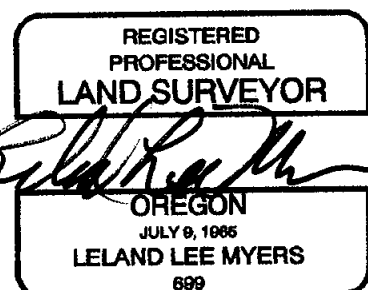

Renewal Date 1/1/97

T10S R37E G-17