

CERTIFIED RECORD OF LAND CORNER MONUMENTATION

History of original corner establishment:

Not previously set.

DIAGRAM

T10S R37E

SW 1/16

+

S9

1994

PLS699

Description of corner evidence found:

Found 1" iron pipe N54°40'E, 20.13 ft. from corner position, origin unknown.

Description of monument and accessories established to perpetuate the original location of this corner:

Set 2" aluminum pipe with 3 1/4" aluminum cap, stamped as shown in diagram, 24" in ground, at a point as determined by the procedures set forth in the MANUAL OF INSTRUCTIONS FOR THE SURVEY OF PUBLIC LANDS for the subdivision of sections, in mound of earth 24" base, 6" high, from which new accessories are:

A 9" Douglas Fir, bears N26°10'E, 12.88 ft., scribed "SW1/16 S9 BT"

A 8" Ponderosa Pine, bears S41°10'E, 7.52 ft., scribed "SW1/16 S9 BT"

Also set galvanized steel posts with "Land Survey Monument" sign 5 ft. S..

I, Leland Lee Myers, 587 E Auburn Street, PO Box 98, Sumpter, OR 97877, do hereby certify that on June 14, 1994, I monumented the corner as herein described.


FILED IN THE OFFICE OF THE BAKER COUNTY SURVEYOR THIS

7 DAY OF Feb, 1995.

10-37-53

Baker County Surveyor

Client: US Forest Service

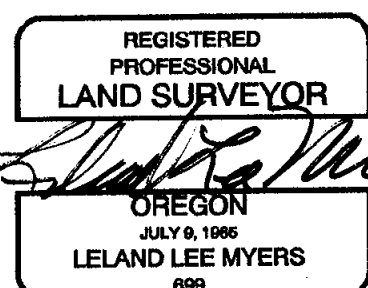

Renewal Date 1/1/97

T10S R37E H-10