

CERTIFIED RECORD OF LAND CORNER MONUMENTATION

History of original corner establishment:

Corner was established by William R. Gradon, US Deputy Surveyor, during the original survey Contract No. 409 dated March, 1882.

"Set a basalt stone 18 x 10 x 6, 12 ins in the ground, for cor. to secs 26,27,34&35, marked with 1 notch on S and 2 notches on E edges, from which:
A pine 40 ins diam. bears N60°E, 92 lks dist, marked T10S R37E S26 BT.
A pine 16 ins diam. bears S45°E, 30 lks dist, marked T10S R37E S35 BT.
A pine 36 ins diam. bears S80°W, 47 lks dist, marked T10S R37E S34 BT.
A pine 36 ins diam. bears N75°W, 54 lks dist, marked T10S R37E S27 BT."

In 1971 the Bureau of Land Management monumented the corner as follows:

"The cor. of secs. 26, 27, 34 and 35, monumented with a mound of stone, 2 1/2 ft. base, 1 ft. high, from which the remains of the original bearing trees:

A pine snag, 44 ins. diam., bears N58°E, 92 lks. dist., with scribe marks T10S R37E S26 BT visible on open blaze.(Record, N60°E)

A pine , 18 ins. diam., bears S45°E, 30 lks. dist., with healed blaze.

A root hole, bears S80°W, 47 lks. dist., with a down pine alongside, 36 ins. diam., no marks visible.

A pine stump, size indeterminate, bears N75°W, 54 lks. dist., no marks visible.

At the corner point set an iron post 28 ins. long, 2 1/2 ins, diam., 18 ins. in the ground, to bedrock, supported in a collar of stone, 3 ft. base, to top, with brass cap mkd. as shown on diagram,

from which new bearing trees:

A ponderosa pine, 8 ins. diam., bears N25°E, 46 lks. dist., mkd. T10S R37E S26 BT.

A ponderosa pine, 10 ins. diam., bears S12°E, 119 lks. dist., mkd. T10S R37E S35 BT.

A ponderosa pine, 18 ins. diam., bears S81°W, 40 1/2 lks. dist., mkd T10S R37E S34 BT.

No other trees available within limits.

Bury a basalt stone, 9 x 7 x 3 ins., with an X chiseled on W. face, alongside iron post."

Description of corner evidence found:

Found 1971 BLM brass cap in good condition, stamped as shown on diagram, with steel post set alongside, from which:

A 10" Ponderosa Pine, bears N23°45'E, 29.9 ft., dead and standing with blaze still visible.(Record, N25°W, 46 lks.)

Description of monument and accessories I established to perpetuate the original location of this corner:

Maintained corner by attaching "Land Survey Monument" signs to steel post and bearing trees as needed, painting 6" wide red bands around bearing trees, and making new accessories:

A 5" Ponderosa Pine, bears N80°15'E, 214.8 ft., scribed "X BT"

A No. 5 rebar with 1 1/2" aluminum cap, bears S25°15'W, 7.62 ft., stamped"RM"

A No. 5 rebar with 1 1/2" aluminum cap, bears N69°20'W, 7.24 ft., stamped"RM"

Sawed of the dead BT to be about 6 feet high. This corner is in an area that was badly burned by a forest fire and nearly all the trees have been killed and many were totally consumed by the fire.

I, Leland Lee Myers, 587 E Auburn Street, PO Box 98, Sumpter, OR 97877, do hereby certify that on November 19, 1994, I maintained the corner as herein described.

FILED IN THE OFFICE OF THE BAKER COUNTY SURVEYOR THIS
7 DAY OF Feb, 1995.

10-37-71

Baker County Surveyor

Client: Lyle Defrees & US Forest Service

DIAGRAM

T10S R37E

S27


S26

S34

S35

1971

BLM

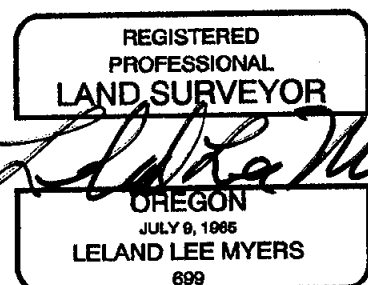

Renewal Date 1/1/97

T10S R37E V-17