

# CERTIFIED RECORD OF LAND CORNER MONUMENTATION

History of original corner establishment:

Not previously set.

DIAGRAM
T 10 S R 37 E
C 1/4 S 8
RLS 1060
1995

Description of corner evidence found:


Corner is being set this survey.

Description of monument and accessories I established to perpetuate the original location of this corner:


At the point, determined by the procedures in the MANUAL OF INSTRUCTION FOR THE SURVEY OF PUBLIC LANDS, set a USFS 3 1/4" aluminum capped monument 12" in the ground, with mound of stones to cap, from which:

A pine, 9" in diam., bears S.75°W., 8.4 ft., double blazed and scribed "C1/4S8BT" with nail and brass washer "RLS 1060", on face of blaze.

A pine, 9" in diam., bears S.45°50'E., 32.8 ft., double blazed and scribed "C1/4S6BT" with nail and brass washer "RLS 1060", on face of blaze.

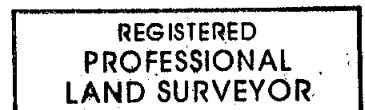

*R. David Schurian* 7-15-96

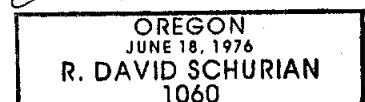

Office of \_\_\_\_\_ County of \_\_\_\_\_  
State of \_\_\_\_\_ I hereby certify that the within instrument was filed in this office  
for record on the \_\_\_\_ day of \_\_\_\_\_, 19\_\_\_\_  
by \_\_\_\_\_

(COUNTY OFFICIAL)

(DEPUTY)

G-7

FILED 7-15-96

BAKER COUNTY SURVEYOR

SURVEY NO. 10-37-86