

CERTIFIED RECORD OF LAND CORNER MONUMENTATION

History of original corner establishment:

William R. Graddon, U.S. Deputy Surveyor
July 1, 1882

40.00 Set a post 3 ft. long, 3 ins. square, 24 ins. in the ground for ¼ sec. cor. marked ¼S on W. face, from which:

- A pine, 10 ins. diam., bears N.40°E., 60 lks. dist., mkd. ¼SBT.
- A pine, 24 ins. diam., bears N.54°W., 15 lks. dist., mkd. ¼SBT.

Owen C. Chatters, II and Lester E. Fisher, Cadastral Surveyors
July 26, 1974

The ¼ sec. cor. of secs. 8 and 9, determined at record bearing and distance from the remains of the original bearing trees:

- A pine, 18 ins. diam., bears N.40°E., 60 lks. dist., with scribe marks ¼ S BT visible on partially opened blaze.
- A decayed pine stump, size indeterminate, bears N.54°W., 15 lks. dist., no marks visible.

At the corner point

Set an iron post, 28 ins. long, 2½ ins. diam., 24 ins. in the ground, with brass cap, from which new bearing trees:

- A ponderosa pine, 10 ins. diam., bears N.60°E., 61 lks. dist., mkd. ¼ S9 BT.
- A ponderosa pine, 13 ins. diam., bears S.67°W., 52 lks. dist., mkd. ¼ S8 BT.

Bury a basalt granite stone, 6 x 5 x 4 ins., with an X chiseled on W. face, alongside iron post.

Description of corner evidence found:

Found a 3" BLM brass cap 0.4' out of the ground in a N-S fence line with no stones, from which:

- A pine, 23" diam., bears N.37°45'E., 39.9', scribed "¼SBT".
- A pine, 14" diam., bears N.58°04'E., 40.6', with healed blaze.
- A pine, 16" diam., bears S.65°05'W., 33', with healed blaze.

Description of monument and accessories I established to perpetuate the original location of this corner:


A 5/8" x 18" rebar with a 2 ½ " aluminum cap, marked "CS1/16S8RM RLS 1060 1996", bears S.52°01'E., 19.3'.

Office of _____ County of _____
State of _____ I hereby certify that the within instrument was filed in this office
for record on the _____ day of _____, 19____
_____ by _____

(COUNTY OFFICIAL)

(DEPUTY)

G-9

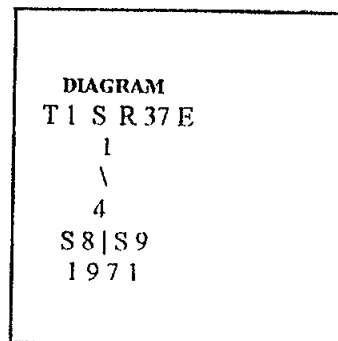

REGISTERED
PROFESSIONAL
LAND SURVEYOR

OREGON
JUNE 18, 1976
R. DAVID SCHURIAN
1060

FILED 7-15-96
PAKER COUNTY SURVEYOR
SURVEY NO. 10-37-88