

CERTIFIED RECORD OF LAND CORNER MONUMENTATION

History of original corner establishment:

William R. Gradon, U.S. Deputy Surveyor
July 1, 1882

80.00 Set post 4 ft. long, 4 ins. square, 24 ins. in the ground, for the cor. to secs. 16, 17, 20, and 21, marked

T10S S16 on N.E.,
R37E S21 on S.E.,
S20 on S.W., and
S17 on N.W. faces, with 3 notches on S. and 4 notches on E. edges, from which:

- A tamarack, 16 ins. diam., bears N.60°E., 35 lks. dist., mkd. T10S R37E S16 BT.
- A tamarack, 20 ins. diam., bears S.70°E., 25 lks. dist., mkd. T10S R37E S21 BT.
- A tamarack, 15 ins. diam., bears S.35°W., 14 lks. dist., mkd. T10S R37E S20 BT.
- A fir, 24 ins. diam., bears N.15°W., 51 lks. dist., mkd. T10S R37E S14 BT.

Owen C. Chatters, II and Lester E., Fisher, Cadastral Surveyors
July 26, 1974

The cor. of secs. 16, 17, 20, and 21, perpetuated by person(s) unknown, monumented with an iron pipe, 2½ ins. diam., firmly set, projecting 10 ins. above the ground, alongside of which is the white wooden post, 4 ins square, firmly set, projecting 4 ins. above ground, from which the remains of the original bearing trees:

- A root hole, bears N.60°E., 35 lks. dist., with a down and decayed western larch alongside, size indeterminate, no marks visible.
- A root hole, bears S.70°E., 25 lks. dist., with a down and decayed western larch alongside, size indeterminate, with scribe marks BT visible on open blaze.

At the corner point

Set an iron post, 28 ins. long, 2½ ins. diam., 24 ins. in the ground, with brass cap, from which new bearing trees:

- A white fir, 14 ins. diam., bears N.22°E., 87 lks. dist., mkd. T10S R37E S21 BT.
- A ponderosa pine, 18 ins. diam., bears S.58°E., 124 lks. dist., mkd. T10S R37E S21 BT.
- A western larch, 11 ins. diam., bears S.65°W., 167 lks. dist., mkd. T10S R37E S20 BT.
- A ponderosa pine, 21 ins. diam., bears N.39°W., 280 lks. dist., mkd. T10S R37E S17BT.

Bury basalt stone, 11 x 9 x 5 ins., with an X chiseled on W. face, and reset wooden post and iron pipe alongside iron post.

The corner is located on the South edge of the new Huckleberry Road, bears N.80°W. and S80°E.

Description of corner evidence found:

Found a 3" BLM brass cap, 0.2' under road side slope, from which:

- A tamarack, 14" diam., bears S.62°56'W., 107.6', with healed blaze
- A pine, 19" diam., bears N.40°58'W., 179.6', scribe marks visible.
- A fir, 20" diam., bears N.20°20'E., 56', with healed blaze.
- A pine, 20" diam., bears S.59°50'E., 79.7', with healed blaze.



Description of monument and accessories I established to perpetuate the original location of this corner:

Office of _____ County of _____
State of _____ I hereby certify that the within instrument was filed in this office
for record on the ____ day of _____, 19____
_____ by _____

(COUNTY OFFICIAL)

(DEPUTY)

N-9

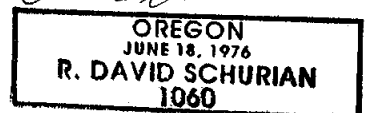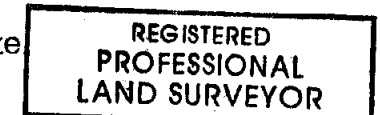

FILED 7-15-96
BAKER COUNTY SURVEYOR
SURVEY NO. 10-37-112