

CERTIFIED RECORD OF LAND CORNER MONUMENTATION

History of original corner establishment:

William R. Gradon, U.S. Deputy Surveyor
July 1, 1882

40.00 Set a basalt stone 12 x 10 x 5 ins., 8 ins. in the ground, for $\frac{1}{4}$ sec. cor., marked $\frac{1}{4}$ on W. face, from which:

A pine, 7 ins. diam., bears S.45°E., 39 lks. dist., mkd. $\frac{1}{4}$ SBT.
A pine, 6 ins. diam., bears S.78°W., 31 lks. dist., mkd. $\frac{1}{4}$ SBT.

Owen C. Chatters, II and Lester E., Fisher, Cadastral Surveyors
July 26, 1974

The $\frac{1}{4}$ sec. cor. of secs. 22 and 23, monumented with the original basalt stone, 12 x 10 x 5 ins., firmly set 10 ins. in the ground, mkd $\frac{1}{4}$ on W. face, from which the remains of the original bearing trees:

A root hole, bears S.45°E., 39 lks. dist., with a down pine alongside, 7 ins. diam., with scribe marks $\frac{1}{4}$ S BT visible on open blaze.
A root hole, bears S.78°W., 31 lks. dist., with a down pine alongside, 16 ins. diam., with scribe marks $\frac{1}{4}$ S BT visible on open blaze.

At the corner point

Set an iron post, 28 ins. long, 2 $\frac{1}{2}$ ins. diam., 24 ins. in the ground, with brass cap, from which new bearing trees:

A western larch, 10 ins. diam., bears N.24°E., 16 lks. dist., mkd. $\frac{1}{4}$ S23BT
A fir, 11 ins. diam., bears N.60°W., 17 lks. dist., mkd. $\frac{1}{4}$ S22BT.

Bury corner stone alongside iron post.

Description of corner evidence found:

Found a BLM brass cap, 0.3' above the ground with no stones, from which:

A tamarack, 12" diam., bears N.19°57'E., 11.2', with healed blaze.
A fir, 15" diam., bears N.61°33'W., 11.7', with healed blaze.

Description of monument and accessories I established to perpetuate the original location of this corner:


A 5/8" x 18" rebar, with an 2 1/2" aluminum cap, marked " $\frac{1}{4}$ 23 RM RLS 1060, with an arrow pointing to the monument, bears S.40°25'E., 10.4 ft. RLS 1060, with an arrow pointing to the monument".
A 5/8" x 18" rebar, with an 2 1/2" aluminum cap, marked " $\frac{1}{4}$ 22 RM RLS 1060, with an arrow pointing to the monument, bears N.61°33'W., 11.7 ft.

Office of _____ County of _____
State of _____ I hereby certify that the within instrument was filed in this office
for record on the ____ day of _____, 19____
_____ by _____

(COUNTY OFFICIAL)

(DEPUTY)

P-17

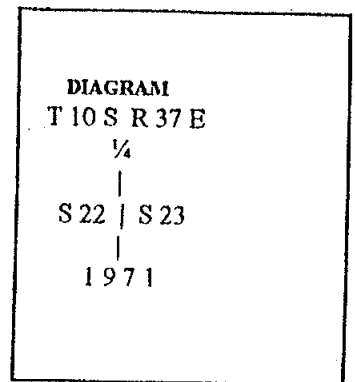

REGISTERED
PROFESSIONAL
LAND SURVEYOR

R. David Schurian 7-15-96

OREGON
JUNE 18, 1976
R. DAVID SCHURIAN
1060

FILED 7-15-96
BAKER COUNTY SURVEYOR
SURVEY NO. 10-37-117