


CERTIFIED RECORD OF LAND CORNER MONUMENTATION

History of original corner establishment:

Eugene P. McCornack U.S. Deputy Surveyor
October 15, 1881

80.00 Set post 4 ft long 4 ins. square 24 ins in the ground for cor to secs 25,30,31 and 36
marked
T10S S30 on NE
R38E S31 on SE
R37E S36 on SW and
S25 on NW with 5 notches on N and 1 notch on S edges from which

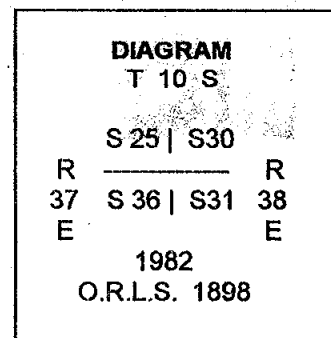

A pine, 22" in diam., bears N.15°E., 65 lks., dist. marked T10SR38ES30BT.
A pine, 14" in diam., bears S.85°E., 34 lks., dist. marked T10SR38ES31BT.
A pine, 24" in diam., bears S.65°W., 55 lks., dist. marked T10SR38ES36BT.
A tamarack, 20" in diam., bears N.40°W., 98 lks., dist. marked T10SR38ES25BT.

William R. Grandon U.S. Deputy Surveyor
March 28, 1882

80.37 Intersects W boundary 17 lks S of cor to secs 25, 30, 31 and 36 which is a post, 4 ins. square firmly set in the ground and marked T10S S30 on NE, R38E S31 on SE, R37E S36 on SW and, S25 on NW with 5 notches on N and 1 notch on S edges from which

A pine, 22" in diam., bears N.15°E., 65 lks., dist. marked T10SR38ES30BT.
A pine, 14" in diam., bears S.85°E., 34 lks., dist. marked T10SR38ES31BT.
A pine, 24" in diam., bears S.65°W., 55 lks., dist. marked T10SR38ES36BT.
A tamarack, 20" in diam., bears N.40°W., 98 lks., dist. marked T10SR38ES25BT.

Harry C. Hildebrand Oregon L.S.
July 19, 1982

At the corner I found no evidence of the original corner post. I found the NW BT to be 24" stump marked BT bearing N41°W 64.7 ft. The SW BT is a 30" stump marked BT bears S70°W 36.3 ft. There are rotted remains of the two remaining BTs at proper bearing and distances.

At the intersect of the distances of the two BTs I set a 2½" x 32" aluminum capped pipe 26" in the ground from which:

A 6" ponderosa pine, bears S.37°30'W., 27.33 ft., marked T10SR37ES36BT nail in E. base.
An 11" ponderosa pine, bears N.63°30'W., 20.79 ft., marked T10SR37ES25BT nail in S. base.
A 13" ponderosa pine, bears N.68°E., 8.54 ft., marked T10SR37ES30BT nail in SE. base.
A 14" ponderosa pine, bears S.30°E., 20.88 ft., marked T10SR37ES31BT nail in E. base.

Bearings taken with a staff compass declination 18½° East per 1980 Isogonic chart.

Distances pulled to 60d nail with brass washers stamped LS 1898 set in the side center of bearing trees.

Description of corner evidence found:

Found a USFS 2½" brass cap, 2" out of the ground, with a stone mound to the cap, marked as per diagram.

From which:

A stump, 11" in diam., bears N.72°E., 8.2 ft., with visible scribe marks "T10SR38ES30BT".
A stump, 12" in diam., bears S.33°E., 21.0 ft., with visible scribe marks "T10SR38ES30BT".
A dead and down burnt tree, bears S.38°W., 27.5 ft., with visible scribe marks "T10SR37ES36BT".
A burnt stump, 10" in diam., bears N.61°W., 20.7 ft., with visible scribe marks "T10SR37ES25BT".

Description of monument and accessories I established to perpetuate the original location of this corner:

Set a 5/8" x 24" rebar, with an 2" aluminum cap marked with an arrow pointing to the corner, the bearing and distance, and" RLS 1060 1997" on the bottom bears, N.40°E., 14.9'.
Set a 5/8" x 24" rebar, with an 2" aluminum cap marked with an arrow pointing to the corner, the bearing and distance, and" RLS 1060 1997" on the bottom bears, S.53°E., 17.4'.
Set a 5/8" x 24" rebar, with an 2" aluminum cap marked with an arrow pointing to the corner, the bearing and distance, and" RLS 1060 1997" on the bottom bears, S.40°W., 23.5'.
Set a 5/8" x 24" rebar, with an 2" aluminum cap marked with an arrow pointing to the corner, the bearing and distance, and" RLS 1060 1997" on the bottom bears, N.53°W., 13.2'.

Placed Forest Service signs (54-2,54-9) on trees and paint scars, blazes and a 6" red band around BT's.
Placed two steel fence posts three to five feet from corner near property line with Forest Service signs (54-2).

Office of _____ County of _____
State of _____ I hereby certify that the within instrument was filed in this office
for record on the ____ day of _____, 19____
_____ by _____
(COUNTY OFFICIAL) (DEPUTY)

V-1

FILED May 29, 1998
BAKER COUNTY SURVEYOR
SURVEY NO. 10-37-121/10-38-131