

CERTIFIED RECORD OF LAND CORNER MONUMENTATION

History of original corner establishment:

Corner not previously established.

**DIAGRAM**

T10S R37E  
N1/16  
S5 | S4  
1983  
PLS848

Description of corner evidence found:

N/ A

Description of monument and accessories | established to perpetuate the original location of this corner:

Set a 2½"x30" aluminum pipe with a 2½" aluminum cap stamped as shown in diagram.  
Set 25" in the ground.

From which:


A Pine 10" dia. bears S57°18'E, 17.0 ft. scribed N1/16 S4 BT.

A Tamarack 16" dia. bears S42°08'W, 62.9 ft. scribed N1/16 S5 BT.

Nailed brass washers stamped PLS848, bearing tree and warning signs to each tree.

Set steel posts with warning and boundry signs South 5 ft. and West 5 ft.

Painted 6" red band around each tree.

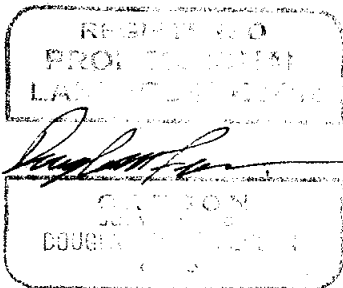

Corner monumented 8-19-83

Witnessed by Dan Martin

Office of..... County of.....

State of....., I hereby certify that the within instrument was filed in this office

for record on the..... day of....., 19.....

..... by .....

(COUNTY OFFICIAL)

(DEPUTY)

Form R6-7100-57 (9/71)

FILED Nov. 17, 1983

☆ GPO—798-276

BAKER COUNTY SURVEYOR

SURVEY NO. 10-37-28