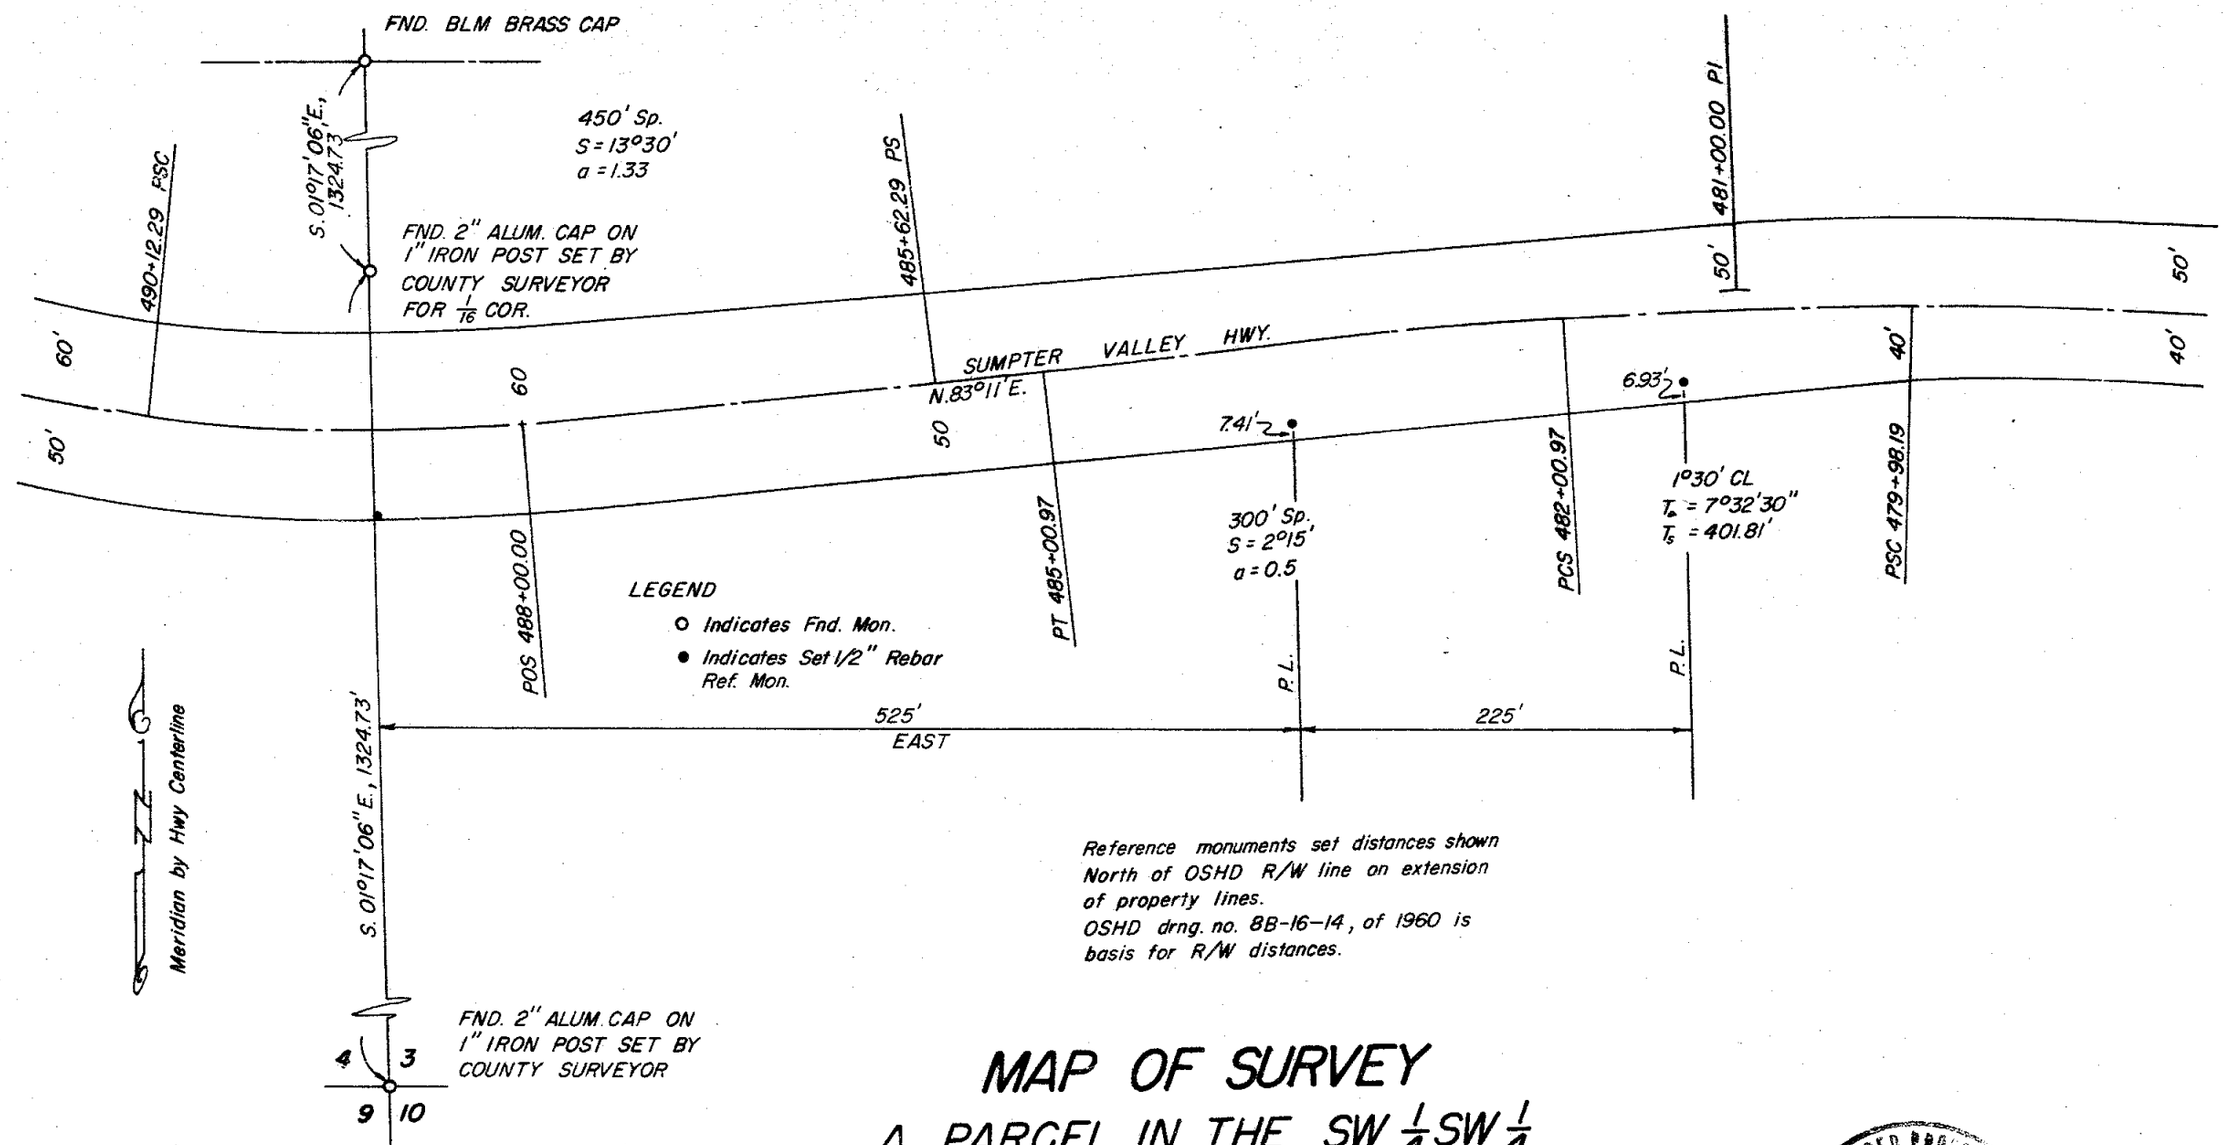

Reference monuments set distances shown North of OSHD R/W line on extension of property lines.
OSHD drng. no. 8B-16-14, of 1960 is basis for R/W distances.

MAP OF SURVEY

A PARCEL IN THE SW $\frac{1}{4}$ SW $\frac{1}{4}$

SEC. 3, T. 10 S., R. 37 E., W.M.

Surveyed April 21, 1975 Scale 1" = 100'

For John Mitchell

FILED 5-5-75
BAKER COUNTY SURVEYOR
SURVEY NO. 10-37-8

REGISTERED PROFESSIONAL ENGINEER
2808
James D. Hanley
OREGON
May 7, 1948
JAMES D. HANLEY