

CERTIFIED RECORD OF LAND CORNER MONUMENTATION

**History of original corner establishment:**


Corner established by William R. Gradon under GLO contract no. 409, dated March 28, 1882.

**Surveyor General records state:**

Set a basalt stone 16x8x4 ins. 11 ins in the ground for 1/4 sec. cor. marked 1/4 on W face, from which:

A fir 10 ins diam bears S 35° E, 62 lks dist marked 1/4 S BT

A fir 20 ins diam bears N 75° W, 41 lks dist marked 1/4 S BT

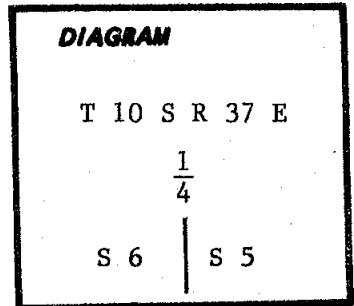

**Description of corner evidence found:**

At approximate corner location found a rotted tree, lying down, with visible scribe marks and USFS bearing tree tag attached marked "...N 35° W, 61 lks JRM 8-31-73..." for Section 5 BT.

Found rotten stump hole for Section 6 BT.

At location determined from these accessory bearing trees, found a mound of stone and original stone buried and alongside of mound, marked 1/4.

**Description of monument and accessories | established to perpetuate the original location of this corner:**

Set a 2½ inch aluminum cap on a 1 inch iron pipe, 31 inches long, and projecting 6 inches out of the ground with a surrounding earth and rock mound. Buried original stone alongside aluminum cap monument.

Aluminum cap marked thus:

T 10 S R 37 E

$\frac{1}{4}$

S 6 | S 5

CS 1975

I hereby certify that the above described corner monument was properly established under my supervision on May 23, 1975, and witnessed by Bill Hanley and Brad Gordon.



Office of..... County of.....  
State of....., I hereby certify that the within instrument was filed in this office  
for record on the..... day of....., 19.....  
..... by .....  
(COUNTY OFFICIAL) (DEPUTY)

Form R6-7100-51 (9/71)

FILED JUNE 17, 1982  
BAKER COUNTY SURVEYOR  
SURVEY NO. 10-37-9

☆ GPO—798-278