

CERTIFIED RECORD OF LAND CORNER MONUMENTATION

History of original corner establishment:


Original survey done by William R. Graden under contract No. 409 dated March 1882

Set a basalt stone 12X10X5 ins 8 ins in the ground for 1/4 sec. cor marked 1/4 on W. face from which

A pine 18 ins diam bears N80° E 82 lks dist marked 1/4 S BT

A pine 20 ins diam bears S35° W 77 lks dist marked 1/4 S BT

In 1965 McCarter & Tuller Consulting Engrs. from Boise Idaho found the corner and drove a 2 1/2" X 27" iron pipe to mark the corner.

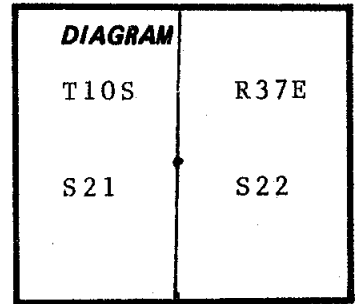

Description of corner evidence found:

At the corner I found the 2 1/2" X 27" iron pipe set by McCarter & Tuller. I also found the original bearing trees. A pine stump bears N80° E 54.1 ft. marked BT. A pine stump 22" diam bears S35° W 50.8 ft. marked 1/4 S BT.

I also found a stone of the dimensions called but could not see any marks.

Description of monument and accessories I established to perpetuate the original location of this corner:

I replaced the 2 1/2" X 27" iron pipe with a 2 1/2" X 32" brass capped steel pipe set 26" in the ground in a mound of stone from which

A 13" Ponderosa Pine bears N84° 15' E 65.55 ft. marked 1/4 S 22 BT Nail in N. base.


A 13" Ponderosa Pine bears N83° 15' W 39.17 ft. marked 1/4 S 21 BT Nail in N. base.

Power Pole No. 152 bears South 121.5 ft.

Bearings taken with a staff compass. Declination 18 1/2° E. per 1980 Isogonic chart. Distances pulled to 60d nails with a brass washer marked L.S. 1898 set in side center of bearing trees.

Monument stamped:

T10S  
1/4 COR  
S21 | S22  
1982  
O.R.L.S 1898

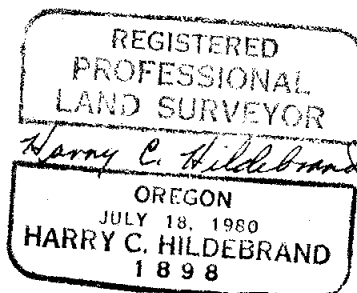

R  
37  
E

Office of.....Surveyor..... County of.....Baker.....  
State of.....Oregon....., I hereby certify that the within instrument was filed in this office  
for record on the..... day of....., 19.....

..... by .....  
(COUNTY OFFICIAL) (DEPUTY)

Form R6-7100-57 (9/71)

FILED July 19, 1982  
BAKER COUNTY SURVEYOR  
SURVEY NO. 10-37-14

☆ GPO—798-276  
P-13