

CERTIFIED RECORD OF LAND CORNER MONUMENTATION


History of original corner establishment:

Original survey by Eugene P. McCornack under contract No. 398 dated August 1881.

Set post 3ft long 3ins square 24ins in the ground for $\frac{1}{4}$ sec cor marked $\frac{1}{4}$ S on W. face from which;

A Pine 8ins in diam bears S 85° E 12 lks dist marked $\frac{1}{4}$ S B T

A Pine 12ins in diam bears S 60° W 18 lks dist marked $\frac{1}{4}$ S B T

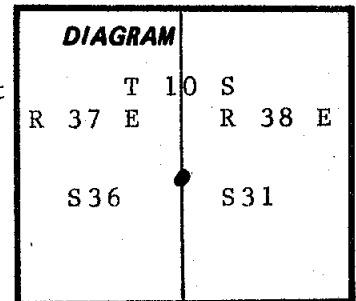

Description of corner evidence found:

At the corner location I found no evidence of the original post. I found a 23" living Ponderosa pine bearing N 79° E 7.9ft with a healed over scare I had to open and found $\frac{1}{4}$ marked on the tree. I also found a 26" pine dead and down with a healed over blaze I opened it and found it marked B T.

Description of monument and accessories | established to perpetuate the original location of this corner:

At the intersection of the called distances between the two B Ts I set a $2\frac{1}{2}$ "X 32" Brass Capped Steel pipe 24" in the ground in a mound of stone from which;

A 13" Ponderosa pine bears S $26^{\circ} 15'$ E 15.95ft. marked $\frac{1}{4}$ S31 BT nail in S. base


A 6" Western larch bears S $80^{\circ} 15'$ W 30.11ft. marked $\frac{1}{4}$ S36 BT nail in S. base

Bearings taken with a staff compass declination $18\frac{1}{2}$ East per 1980 Isogonic chart.

Distances pulled to 60d nails with brass washers marked LS 1898 set in the side center of bearing trees.

Monument stamped

T10S
 $\frac{1}{4}$ COR.
 R 37 S36 S31 38 R
 E E
 1982
 OR L S 1898

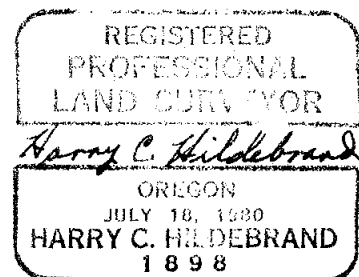

7-17-82

Office of.....Surveyor..... County of.....Baker.....
 State of...Oregon....., I hereby certify that the within instrument was filed in this office
 for record on the..... day of....., 19.....
 by
 (COUNTY OFFICIAL) (DEPUTY)

Form R6-7100-57 (9/71)

FILED July 19, 1982
 BAKER COUNTY SURVEYOR
 SURVEY NO. 10-37-18
10-38-23

X-25

☆ GPO—798-276