


CERTIFIED RECORD OF LAND CORNER MONUMENTATION

**History of original corner establishment:**

Corner originally established by Hanley Engineering as a part of Three Bar Ranch Lands subdivision on July 14, 1972.

Set a 5/8-inch rebar with a yellow plastic cap marked RPE  
2808

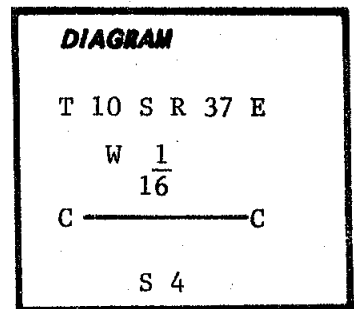

**Description of corner evidence found:**

Found a 5/8-inch rebar with an extensively obliterated yellow plastic cap at a position which bears East, 1.11 feet from true corner position.

**Description of monument and accessories established to perpetuate the original location of this corner:**

At the true corner position set a 2½-inch brass cap on a 2-inch iron pipe 31 inches long and projecting 6 inches out of the ground with a surrounding rock mound.

Brass cap marked thus: T 10 S R 37 E

W  $\frac{1}{16}$   
C ——— C  
S 4  
1982

ORLS 1639

**New bearing trees established:**

A ponderosa pine, 14 inches diam bears S 14° W, 31.2 feet dist marked WC 1/16 S 4 BT  
A ponderosa pine, 7 inches diam bears S 68° W, 15.1 feet dist marked WC 1/16 S 4 BT

Each new bearing tree has a sign 54-3 attached below a 6 inch band of red paint and has a brass washer marked PLS 1639 nailed flush with BT blaze.

I hereby certify that the above corner monument was properly remonumented on August 3, 1982, by me and witnessed by Jim DeMastus.

**REGISTERED  
PROFESSIONAL  
LAND SURVEYOR**

*William L Hanley*

OREGON  
JULY 14, 1978  
WILLIAM L. HANLEY  
1639

Office of..... County of.....

State of....., I hereby certify that the within instrument was filed in this office

for record on the..... day of....., 19.....

..... by .....

(COUNTY OFFICIAL)

(DEPUTY)

Form R6-7100-57 (9/71)

FILED Aug. 4, 1982

BAKER COUNTY SURVEYOR

SURVEY NO. 10-37-21