

# CERTIFIED RECORD OF LAND CORNER MONUMENTATION

## History of original corner establishment:

Corner established in 1882 by William R. Groden, Under General Land Office Contract No. 409. Surveyor Generals Notes State; Set a granite stone 18x10x10" 12" in ground for corner to sections 4,5,8,& 9 marked with 5 notches on S and 4 notches on E edges, From which:

- A Pine 44" dia. bears N40°E, 1301ks dist. marked T10S R37E S4 BT.
- A " 36" dia. bears S30°E, 1391ks dist. marked T10S R37E S9 BT.
- A " 36" dia. bears S70°W, 28 lks dist. marked T10S R37E S8 BT.
- A " 36" dia. bears N5°W, 64 lks dist. marked t10S R37E S5 BT.

## DIAGRAM

|        |      |
|--------|------|
| T10S   | R37E |
| S5     | S4   |
| S8     | S9   |
| 1971   |      |
| B.L.M. |      |

CONTINUED ON ATTACHED SHEET

## Description of corner evidence found:

Found brass cap monument set in ground in good condition, stamped as shown on the diagram. with steel post set alongside.

From which:



- A Pine 12" dia. blaze healed over, bears S65°W, 3.0 ft.
- A " 37" dia. (original tree) with scribing visible bears N2°W, (N5°W) 43.2 ft.
- A Pine 14" dia. blaze healed over bears N70°E, (N68°E) 39.0 ft 39.0 ft. (39.6).
- A " 10" dia. blaze healed over bears S55°E, (S58°E) 49.7 ft. (50.2)

## Description of monument and accessories | established to perpetuate the original location of this corner:

Maintained corner by wiring warning sign to steel post set NE alongside pipe.  
Maintained bearing trees by nailing bearing tree signs above blazes where needed, mailing waring signs to the backs of the trees where needed and painting a 6" red band around each tree.

Corner monumented 8-19-83

Witnessed by Dan Martin

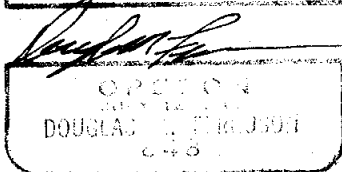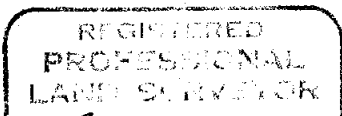

Office of..... County of.....

State of....., I hereby certify that the within instrument was filed in this office for record on the..... day of....., 19.....

..... by .....  
(COUNTY OFFICIAL) (DEPUTY)

Form R6-7100-57 (9/71)

FILED Nov. 17, 1983  
BAKER COUNTY SURVEYOR  
SURVEY NO. 10-37-25

☆ GPO—798-276