

CERTIFIED RECORD OF LAND CORNER MONUMENTATION

History of original corner establishment:

Corner not previously established.

DIAGRAM

T10S R37E
E 1/16
C ——— C
S5
1983
WC ↓ 17.8
PLS848

Description of corner evidence found:

N/A

Description of monument and accessories I established to perpetuate the original location of this corner:

Set a 5/8"x30" iron pin with plastic cap mkd. PLS848, survey marker, set flush with surface of roadway.


From which:

Set a 2½" x30" aluminum pipe with 2½" aluminum cap for witness corner, stamped as shown in diagram. Bears N4°18'31"W, 17.80 ft. from pin.

A Pine 7" dia. bears N78°13'E, 28.1 ft. from pin, scribed C-E 1/16 S5 BT.


A " 11" dia. bears S88°54'W, 29.6 ft. from pin, scribed C-E 1/16 S5 BT.

Set steel posts with warning and boundry signs N4°18'W, 27.6 ft. from pin, and West 23.7 ft. from pin.

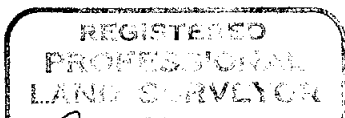

Corner monumented 8-19-83

Witnessed by Dan Martin

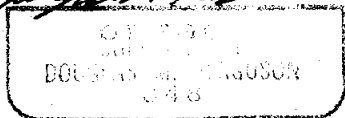

Office of..... County of.....

State of....., I hereby certify that the within instrument was filed in this office for record on the..... day of....., 19.....

..... by
(COUNTY OFFICIAL) (DEPUTY)

Form R6-7100-57 (9/71)

FILED Nov. 17, 1983

BAKER COUNTY SURVEYOR

SURVEY NO. 10-37-29