

CERTIFIED RECORD OF LAND CORNER MONUMENTATION

History of original corner establishment:

Corner not previously established.

DIAGRAM

T10S R37E
NE1/16
S5
1983
PLS848

Description of corner evidence found:

N/A

Description of monument and accessories | established to perpetuate the
original location of this corner:

Set a 30"x2½" aluminum pipe with a 2½" aluminum cap stamped as shown in diagram.
Set 20" in the ground.

From which:


A Fir 8" dia. bears N50°20'E, 12.6 ft. scribed NE1/16 S5 BT.

A " 11" " " S50°00'E, 12.1 ft. scribed NE1/16 S5 BT.

Set steel posts with warning and boundry signs South and boundry signs South and East 5 ft.
Nailed brass washers stamped PLS848, bearing tree and warning signs to each tree.
Painted 6" red band around each tree.

Corner monumented 8-19-83

Witnessed by Dan Martin

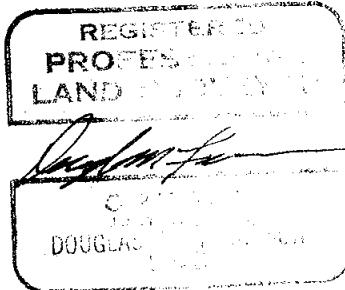

Office of..... County of.....
State of....., I hereby certify that the within instrument was filed in this office
for record on the..... day of....., 19.....

..... by
(COUNTY OFFICIAL) (DEPUTY)

Form R6-7100-57 (9/71)

FILED Nov. 17, 1983
BAKER COUNTY SURVEYOR
SURVEY NO. 10-37-30

☆ GPO—798-276