


CERTIFIED RECORD OF LAND CORNER MONUMENTATION

History of original corner establishment:

Original survey done by William R. Graden under contract No. 409 dated 1882  
Set a post 3 ft by 3 ins square 24 ins in the ground for  $\frac{1}{4}$  sec cor marked  $\frac{1}{4}$  on N. face from which  
A pine 22 ins diam bears N25°W 11 lks dist. marked  $\frac{1}{4}$ S BT  
A pine 22 ins diam bears S5°W 24 lks dist. marked  $\frac{1}{4}$ S BT

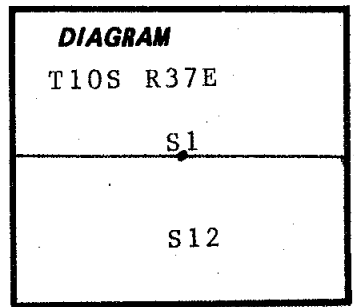

Description of corner evidence found:

At the corner location I found a mound of stone but no evidence of original post.  
I also found the N25°W Bt to be a rotted stump with no visible marks at 7.3 ft. The S5°W Bt is also a stump 22 ins in diam at a distance of 15.8 ft. marked "T" on the lower blaze.

Description of monument and accessories I established to perpetuate the original location of this corner:


Pulling a distance intersect of the two Bt stumps I reset this corner. I set a 2 $\frac{1}{2}$ " X 32" brass capped steel pipe 26" in the ground in a mound of stone from which

An 8" Ponderosa Pine bears S50°30'E 4.79 ft. marked  $\frac{1}{4}$ S12 BT Nail in N. base  
A 5" Ponderosa Pine bears N29°W 6.90ft. marked  $\frac{1}{4}$ S1 BT Nail in W. base

Bearings taken with a staff compass.  
Declination 18 $\frac{1}{2}$ °E. per 1980 Isogonic chart.  
Distances pulled to 60d nails with a brass washer marked L.S.1898 set in side center of bearing trees.

Monument stamped:

T10S  
R 37 S1  
E ———  $\frac{1}{4}$  COR.  
S12  
1982  
O.R.L.S.1898

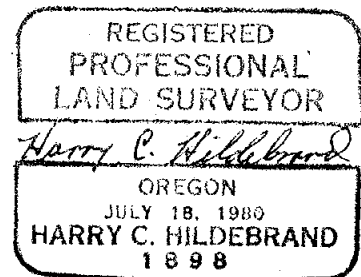

7-19-82

Office of..... Surveyor..... County of..... Baker  
Oregon  
State of....., I hereby certify that the within instrument was filed in this office  
for record on the..... day of....., 19.....  
..... by .....  
(COUNTY OFFICIAL) (DEPUTY)

Form R6-7100-57 (9/71)

FILED July 19 1982  
BAKER COUNTY SURVEYOR  
SURVEY NO. 10-37-11

☆ GPO—798-276

E-23