


CERTIFIED RECORD OF LAND CORNER MONUMENTATION

History of original corner establishment:

Original survey done by William R. Graden
under contract No.409 dated March 1882.
Set a basalt stone 20X8X8 ins 15 ins in the ground
for $\frac{1}{4}$ sec. cor. marked $\frac{1}{4}$ on N. face from which

- A pine 14 ins diam bears S65^oE 23 Lks dist
marked $\frac{1}{4}$ S BT
- A pine 40 ins diam bears S65^oW 80 Lks dist.
marked $\frac{1}{4}$ S BT

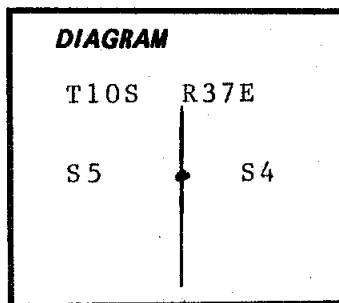

Description of corner evidence found:

At the corner location I found a 5/8" X 30" rebar set in a concrete collar.
I also found a stone 20"X8"X8" in the same location. Could make out no
markings. I also found a rotted stump bearing S65^oW 53 ft. no visible
markings. The other tree has completely rotted away.

Description of monument and accessories I established to perpetuate the
original location of this corner:

At the corner I replaced the 5/8" X 30" rebar
with a 2 $\frac{1}{2}$ " X 32" brass capped steel pipe set
20" in the ground in a mound of stone from which


- A 6" Ponderosa Pine bears N76^o30'W 20.27 ft.
marked $\frac{1}{4}$ S 5 BT nail in N. base
- An 8" Ponderosa Pine bears S76^oE 44.61 ft.
marked $\frac{1}{4}$ S 4 BT nail in N. base.

Monument stamped:

Bearings taken with a staff compass
declination 18 $\frac{1}{2}$ ^oE per 1980 Isogonic chart

Distances pulled to 60d nails with a brass
washer marked L.S. 1898 set in side center
of bearing trees.

T10S
 $\frac{1}{4}$ COR
R 37 5 4
E 1982

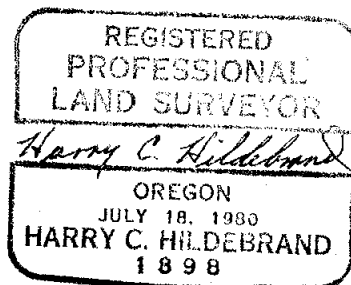

O.R.L.S. 1898

7-19-82

Office of.....Surveyor..... County of.....Baker
State of.....Oregon....., I hereby certify that the within instrument was filed in this office
for record on the..... day of....., 19.....

..... by
(COUNTY OFFICIAL) (DEPUTY)

Form R6-7100-57 (9/71)

FILED July 19, 1982
BAKER COUNTY SURVEYOR
SURVEY NO. 10-37-12

☆ GPO—798-276

C-09